

LAND CORNER RECORDATION CERTIFICATE
Filing Requirement of Act 74, Mich. P.A. 1970

STATE OF MICHIGAN

FILED FOR RECORD THIS
6th DAY OF June 1990
9:30 AM
PAGE 354

or corners in
Crawford
County

Located In: T27N R 1W H-9
I R
T R
T R
Property Controlling S T R
in Section S T R
Miscellaneous S T R
Property in Sec. S T R

Register of Deeds Stamp & File Number

Lot No. Recorded Plat
Private Claims

	A	B	C	D	E	F	G	H	I	J	K	L	M
2	6	5	4	3	2								
3													
4	7	8	9	10	11	12							
5													
6	18	17	16	15	14	13							
7													
8	19	20	21	22	23	24							
9													
10	30	29	28	27	26	25							
11													
12	31	32	33	34	35	36							
13													

Norman C. Caldwell in a field survey on March 19 90

I hereby certify that under requirements of P.A. 74, Michigan P.A. of 1970, the corner points mentioned in lines 1 and 2 above were in conformance with regulations and rules therefore as required in the current manual of survey instructions of the United States Department of the Interior, Bureau of Land Management or by a decree of a Court of Law and/or that the corner points mentioned in lines 3, 4 and 5 above were in conformance with the rules of the Michigan Board of Land Surveyors or by a Decree of a Court of Law, established, re-established, monumented, re-monumented, recovered, found as expressed below:


NOTE: Not more than 4 corners, all in the same town and range, may be recorded on this certificate.

Description of original monument and accessories and/or subsequent restoration:

(H-9) Post set by Pettibone, July 25, 1852.
Spruce Pine 9" N33°W .61 (40.26')
Spruce Pine 8" S21°W .20 (13.20')

Description of corner evidence found and/or method applied in restoring or reestablishing corner:

(H-9) LaGuire, 1934, fnd. orig. gov. post & both BTs
Parker, LS 16939, fnd. 1/2" bar (?), Dec. 3, 1976.
N05°W 16.25' 6" Cedar
S45°E 13.1' 14" Cedar
S75°W 25.45' 4" Cedar
rec. in L 2, pg 104
Gerschbacher, LS 18990, found 1 1/2" iron pipe
10" Tamarack S64°W 28.41 feet
14" Cedar S43°E 13.75 feet
8" Cedar N20°E 4.18 feet
rec. in L 2, pg 336

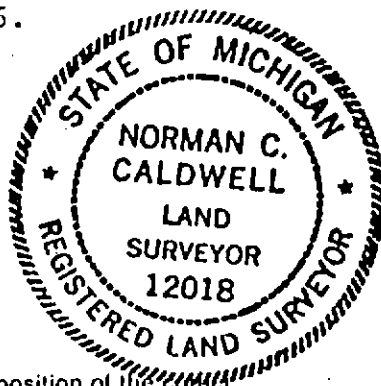

Description of monument for corner and accessories established to perpetuate locating the position of the corner:

(H-9) 1/4 cor. 22&27, T27N-R1W
Fnd. 2" pipe from rec. in L 2, pages 104&336. And is accepted as a careful & faithful perpetuation of the position of the orig. cor.
East 1' Carsonite Witness Post
S45°E 13.7' 16" Cedar (R)
S75°W 25.7' 8" Cedar (R)
N05°W 16.4' 8" Cedar (R)
S60°W 28.5' 12" Spruce

signed by

Date April 26, 1990

Surveyor's Michigan License No. 12018