

LAND CORNER RECORDATION CERTIFICATE
Filing Requirement of Act 74, Mich. P.A. 1970

STATE OF MICHIGAN
COUNTY OF CRAWFORD

FILED FOR RECORD THIS
6th DAY OF June 1990
9:30 am, IN LIBER 2
PAGE 358.
Elizabeth Williams
Register of Deeds

for corners in
Crawford
Public Land Survey Located In: T 27N R 1W Corner Code: I-8
Property Controlling in Section S T R
Miscellaneous S T R
Property in Sec. S T R
Lot No. Recorded Plat
Private Claims

Register of Deeds Stamp & File Number

| | A | B | C | D | E | F | G | H | I | J | K | L | M |
|----|----|----|----|----|----|----|---|---|---|---|---|---|---|
| 2 | 6 | 5 | 4 | 3 | 2 | 1 | | | | | | | |
| 3 | | | | | | | | | | | | | |
| 4 | 7 | 8 | 9 | 10 | 11 | 12 | | | | | | | |
| 5 | | | | | | | | | | | | | |
| 6 | 18 | 17 | 16 | 15 | 14 | 13 | | | | | | | |
| 7 | | | | | | | | | | | | | |
| 8 | 19 | 20 | 21 | 22 | 23 | 24 | | | | | | | |
| 9 | | | | | | | | | | | | | |
| 10 | 30 | 29 | 28 | 27 | 26 | 25 | | | | | | | |
| 11 | | | | | | | | | | | | | |
| 12 | 31 | 32 | 33 | 34 | 35 | 36 | | | | | | | |
| 13 | | | | | | | | | | | | | |

Norman C. Caldwell, a field survey on March 19 90
I hereby certify that under requirements of P.A. 74, Michigan P.A. of 1970, the corner points mentioned in lines 1 and 2 above were in conformance with regulations and rules therefore as required in the current manual of survey instructions of the United States Department of the Interior, Bureau of Land Management or by a decree of a Court of Law and/or that the corner points mentioned in lines 3, 4 and 5 above were in conformance with the rules of the Michigan Board of Land Surveyors or by a Decree of a Court of Law, established, re-established, monumented, re-monumented, recovered, found as expressed below.


NOTE: Not more than 4 corners, all in the same town and range, may be recorded on this certificate.

Description of original monument and accessories and/or subsequent restoration:

(I-8) Post set by Pettibone, July 21, 1852.
Y. Pine 13" S18°W .09 (5.94')
Y. Pine 16" S71°W .55 (36.30')

Description of corner evidence found and/or method applied in restoring or reestablishing corner:

(I-8) C.E. Ostling, LS 12026, fnd. 1/2" bar in pav't. May 9, 1972.
N86°W 29.8' fence cor. post
N51°E 42.5' lot cor.
S87°E 49.35' 20" R. Pine
rec. in L 1, pg 12

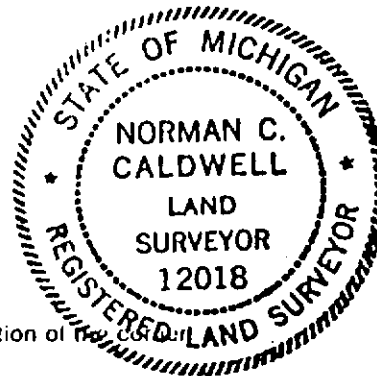

Description of monument for corner and accessories established to perpetuate locating the position of the corner:

(I-8) 1/4 cor. 22&23, T27N-R1W
Fnd. 1/2" bar 1.5' W of CL N-S pav't. per record by C.E. Ostling, L 1, pg 12. Accepted as the best available evidence of the position of the original corner.
East 33' Carsonite Witness Post N50°W 60.9' 8" N. Pine
N86°W 29.8' fe. cor. post (R)
S87°E 49.1' 24" N. Pine (R)
N45°E 44.1' 10" J. Pine
S50°W 54.1' 6" N. Pine

signed by *Norman C. Caldwell*
Surveyor's Michigan License No. 12018

Date April 26, 1990