

LAND CORNER RECORDATION CERTIFICATE  
Filing Requirement of Act 74, Mich. P.A. 1970

For corners in

Crawford  
(County)

Located In:

Corner Code //

- 1. Public Land Survey T 27N R 1W I-10
- 2. Property Controlling in Section S T H
- 1. Miscellaneous S T R
- Property in Sec. S T R

6th June 90  
9:30 AM  
360

Register of Deeds Stamp & File Number

- 1. Lot No. Recorded Plat
- 2. Private Claims

	A	B	C	D	E	F	G	H	I	J	K	L	M
2	6	5	4	3	2	1							
3													
4	7	8	9	10	11	12							
5													
6	18	17	16	15	14	13							
7													
8	19	20	21	22	23	24							
9													
10	30	29	28	27	26	25							
11													
12	31	32	33	34	35	36							
13													

Norman C. Caldwell in a field survey on March 19 90

to hereby certify that under requirements of P.A. 74, Michigan P.A. of 1970, the corner points mentioned in lines 1 and 2 above were in conformance with regulations and rules therefore as required in the current manual of survey instructions of the United States Department of the Interior, Bureau of Land Management or by a decree of a Court of Law and/or that the corner points mentioned in lines 3, 4 and 5 above were in conformance with the rules of the Michigan Board of Land Surveyors or by a Decree of a Court of Law; established, re-established, monumented, re-monumented, recovered, found as expressed below:


NOTE: Not more than 4 corners, all in the same town and range, may be recorded on this certificate.

Description of original monument and accessories and/or subsequent restoration:

- (I-10) Post set by Pettibone, July 21, 1852.  
Y. Pine 17" N76°W .17 (11.22')  
Cedar 12" N62°E .24 (15.84')

Description of corner evidence found and/or method applied in restoring or reestablishing corner:

- (I-10) N. Parker, LS 16939, fnd. 1 3/4" pipe of-unknown origin.  
N60°W 7.55' 5" Spruce  
S10°W 9.65' 10" N. Pine  
N65°E 28.20' 4" J. Pine  
(rec. in L 2, pg 104)  
Gerschbacher, LS 18990, fnd. pipe May 30, 1989  
S66°W 30.37' 12" R. Pine  
S18°W 10.00' 16" R. Pine  
N20°W 39.92' 7" R. Pine  
S80°E 170.48' NW cor. cabin foundation  
(rec. in L 2, pg 336)

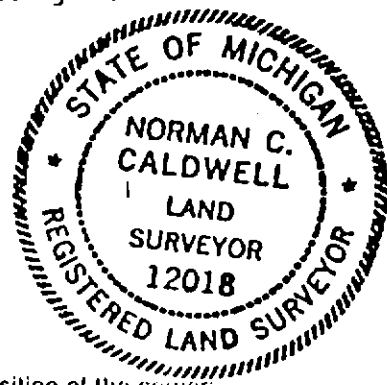

Description of monument for corner and accessories established to perpetuate locating the position of the corner:

- (I-10) 1/4 cor. 26&27, T27N-R1W  
Fnd. rec. 1 3/4" pipe L 2, pg 104 & 336. Accepted as the best available evidence of the position of the original corner.  
North 5' Carsonite Witness Post N76°W 11.2' Y. Pine stump (orig. BT)  
N60°W 7.7' 8" Spruce (R)  
S18°W 10.1' 16" N. Pine (R)  
N65°E 28.5' 6" J. Pine (R)  
S66°W 30.4' 14" N. Pine (R)  
South 10.2' 5/8" bar 3' high

signed by *Norman C. Caldwell*

Date April 26, 1990

Surveyor's Michigan License No. 12018