

LAND CORNER RECORDATION CERTIFICATE
Filing Requirement of Act 74, Mich. P.A. 1970

For corners in

Crawford Located In: Corner Code: //

1. Public Land Survey T 27N. R 1W I-11

2. Property Controlling in Section S T R

3. Miscellaneous Property in Sec. S T R

4. Lot No. Recorded Plat

5. Private Claims

State of Michigan
County of

6th June 1990
9300
361

Register of Deeds Stamp & File Number

Norman C. Caldwell in a field survey on March 19 90 do hereby certify that under requirements of P.A. 74, Michigan P.A. of 1970, the corner points mentioned in lines 1 and 2 above were in conformance with regulations and rules therelore as required in the current manual of survey instructions of the United States Department of the Interior, Bureau of Land Management or by a decree of a Court of Law and/or that the corner points mentioned in lines 3, 4 and 5 above were in conformance with the rules of the Michigan Board of Land Surveyors or by a Decree of a Court of Law, established, re-established, monumented, re-monumented, recovered, found as expressed below:

NOTE: Not more than 4 corners, all in the same town and range, may be recorded on this certificate.

A: Description of original monument and accessories and/or subsequent restoration:

(I-11) Post set by Pettibone, July 21, 1852.
Elm 18" S27°W .25 (16.50')
Dbl. Elm 20" S84°E .27 (17.82')


B. Description of corner evidence found and/or method applied in restoring or reestablishing corner:

(I-11) LaGuire, 1934, placed pipe & conc. block mon. from SE orig. BT Arleth, LS 21266, utilized survey of rec. in L 168, pg 221
S20°W 16.0' 8" Ash
S70°E 20.8' 10" Ash
N76°E 22.5' 12" Poplar

C. Description of monument for corner and accessories established to perpetuate locating the position

(I-11) Sec. cor. 26, 27, 34 & 35, T27N-R1W
Fnd. 1 1/2" pipe by LaGuire. And is accepted as a careful & faithful perpetuation of the position of the original corner.
North 1' Carsonite Witness Post
S69°E 21.0' 10" Ash (R)
S21°W 16.0' 8" Ash (R)
East 30.1' 1/2" bar w/21266 cap
N45°W 29.9' 10" Thornapple

	A	B	C	D	E	F	G	H	I	J	K	L	M
2	6	5	4	3	2	1							
3													
4	7	8	9	10	11	12							
5													
6	18	17	16	15	14	13							
7													
8	19	20	21	22	23	24							
9													
10	30	29	28	27	26	25							
11													
12	31	32	33	34	35	36							
13													

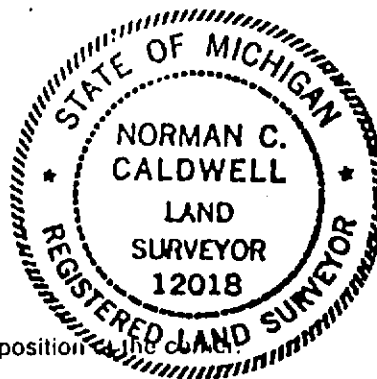

Signed by Norman C. Caldwell Date April 26, 1990

Surveyor's Michigan License No. 12018