LIBER

364PAGE

LAND


, , , , , , , , , , , , , , , , , , , ,	STATE OF MICHIGAN
CORNER RECORDATION CERTIFICATE	COUNTY OF CRAWFORD
Requirement of Act 74, Mich. P.A. 1970	ድፀድስ የ ሰብ የደደፀ

or corners in	Filing Require	ement of Act 74, Mich. P.A. 19	
Crawford	Located In:	Corner Code -//	9: 30 mspin, IN LIBER 2
. Public Land Survey	T 27N R 1W		PAGE364.
 Property Controlling in Section Miscellaneous Property in Sec. 	T R T R S T R S T R S T R		Register of Deeds Register of Deeds Register of Deeds Stamp & File Number
Norman C. Caldwo hereby certify that under recipines 1 and 2 above were in urrent manual of survey instructional anagement or by a decree of cover were in conformance without of Law, established, repressed below: OTE: Not more than 4 con this certificate.	© InIa field survey onMa quirements of P.A. 74, Michigan P.A., in conformance with regulations and uctions of the United States Depart a Court of Law and/or that the corner th the rules of the Michigan Board of re-established, monumented, re-in- corners, all in the same town an	rch 19 90 . of 1970, the corner points mentioned drutes therefore as required in the timent of the interior, Bureau of Land or points mentioned in lines 3, 4 and 5 of Land Surveyors or by a Decree of a monumented, recovered, found as and range, may be recorded	A B C D E F G H J K L 2 6 5 4 3 2 2 3 3 3 4 35 3 3 13 13 13 13 13 13 13 13 13 13 13 13
. Description of original	monument and accessories and	d/or subsequent restoration:	

Post set by Pettibone, July 17, 1852. W. Pine 36" N53°W .37 (24.42') Poplar 17" S78°E .28 (18.48') (J-7)

Description of corner evidence found and/or method applied in restoring or reestablishing corner:

(J-7) LaGuire, 1934, placed pipe & conc. block-mon. from orig. BTs.

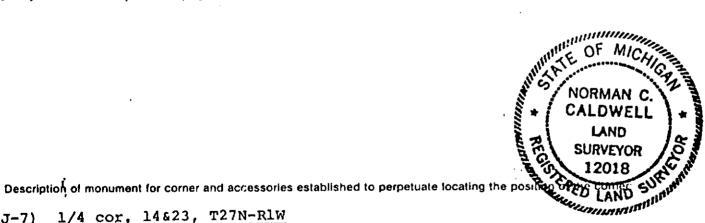

(J-7	1	/4	cor.	14&23,	T27N-R1	N

Fnd. 1 1/2" pipe in conc. block by LaGuire. And is accepted as a careful & faithful perpetuation of the position of the original corner.

Carsonite Witness Post West 1

N53°W 24.4' 24" W. Pine stump (orig . BT)

\$40°E 11.76' 4" W. Pine N & S 16.5' Pits by LaGuire

\$10°W 15.87' 5" W. Pine

\$80°W 35.42' 24" W. Pine

14" N. Pine N20°E 42.6'

aned by	Date _	April 26, 1990
rveyor's Michigan License No12018		FORM APPROVED BY MICHIGAN STATE BUARD UF LAND SURVEYORS, JAN. 28, 1