

LAND CORNER RECORDATION CERTIFICATE
Filing Requirement of Act 74, Mich. P.A. 1970

STATE OF MICHIGAN

FILED FOR RECORD THIS
6th DAY OF June 1990
9:30 AM, IN LIBER 2
PAGE 365.

Edith West
Register of Deeds

Register of Deeds Stamp & File Number

or corners in

Crawford Located In: Corner Code: J-9
(County)

Public Land Survey T27N R 1W J-9
T R
T R
T R

Property Controlling S T R
in Section S T R
Miscellaneous S T R
Property in Sec. S T R

Lot No. _____, Recorded Plat _____
Private Claims _____

Norman C. Caldwell survey on March, 1990.
I hereby certify that under requirements of P.A. 74, Michigan P.A. of 1970, the corner points mentioned in lines 1 and 2 above were in conformance with regulations and rules therefore as required in the current manual of survey instructions of the United States Department of the Interior, Bureau of Land Management or by a decree of a Court of Law and/or that the corner points mentioned in lines 3, 4 and 5 above were in conformance with the rules of the Michigan Board of Land Surveyors or by a Decree of a Court of Law; established, re-established, monumented, re-monumented, recovered, found as expressed below:

NOTE: Not more than 4 corners, all in the same town and range, may be recorded on this certificate.

Description of original monument and accessories and/or subsequent restoration:

- J-9) Post set by Pettibone, July 21, 1852,
Spruce Pine 10" N40°W .40 (26.40')
Spruce Pine 12" S66°W .61 (40.26')


Description of corner evidence found and/or method applied in restoring or reestablishing corner:

- J-9) LaGuire, 1934, placed pipe & conc. block mon. by proportion.
C.E. Ostling, LS 12026, fnd. railroad spike Aug. 20, 1974.
S62°W 31.15' 6" J. Pine
S62°W 39.1' 6" J. Pine
N58°E 84.6' 12" J. Pine
rec. in L 1, pg 17
Parker, LS 16939, fnd. 1/2" bar July 27, 1976
N24°W 55.10' 20" J. Pine
S65°W 31.0' 12" J. Pine
S10°W 39.1' 8" J. Pine
South 27.4' 1 1/2" Pipe
rec. in L 2, pg 57

Description of monument for corner and accessories established to perpetuate locating the position of the original corner:

- J-9) 1/4 cor. 23&26, T27N-R1W
Fnd. 1/2" bar, placed 12018 cap. Frank Smith, LS, Norm Parker, C.E. Ostling rec. L 1, pg 17 & L 2, pg 57. (Near CL E. B. Lane). Accepted as the best available evidence of the position of the original corner.
North 20' Carsonite Witness Post N80°E 116.7' P. Pole
N24°W 55.7' 16" J. Pine (R)
S10°W 39.0' 8" J. Pine (R) (dead)
N58°E 85.0' 14" J. Pine (R) (dead)
South 27.0' 1 1/2" pipe (R) 3' high

	A	B	C	D	E	F	G	H	I	J	K	L	M
2	6	5	4	3	2	1							
3													
4	7	8	9	10	11	12							
5													
6	18	17	16	15	14	13							
7													
8	19	20	21	22	23	24							
9													
10	30	29	28	27	26	25							
11													
12	31	32	33	34	35	36							
13													

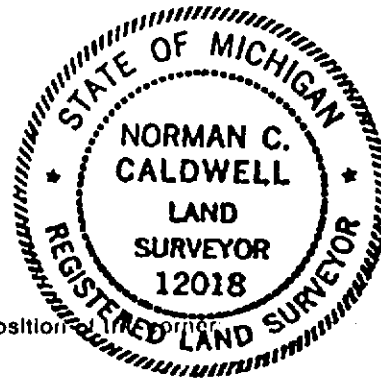

signed by Norman C. Caldwell Date April 26, 1990

Surveyor's Michigan License No. 12018