

LAND CORNER RECORDATION CERTIFICATE
Filing Requirement of Act 74, Mich. P.A. 1970

STATE OF MICHIGAN
COUNTY OF CRAWFORD

FILED FOR RECORD THIS
6th DAY OF June 1990 AT
9:30 am, IN LIBER 2
PAGE 367
Elizabeth D. Wieland
Register of Deeds

or corners in
Crawford (County) Located In: Corner Code: J-13

Public Land Survey T 27N R 1W ----- J-13
T ----- R -----
T ----- R -----
T ----- R -----

Property Controlling S ----- T ----- R -----
in Section S ----- T ----- R -----
Miscellaneous S ----- T ----- R -----
Property in Sec. S ----- T ----- R -----

Register of Deeds Stamp & File Number

Lot No. _____, Recorded Plat _____
Private Claims _____


	A	B	C	D	E	F	G	H	I	J	K	L	M
2	6	5	4	3	2	1							
3													
4	7	8	9	10	11	12							
5													
6	16	17	16	15	14	13							
7													
8	19	20	21	22	23	24							
9													
10	30	29	28	27	26	25							
11													
12	31	32	33	34	35	36							
13													

Norman C. Caldwell in a field survey on March, 1990
I hereby certify that under requirements of P.A. 74, Michigan P.A. of 1970, the corner points mentioned in lines 1 and 2 above were in conformance with regulations and rules therefore as required in the current manual of survey instructions of the United States Department of the Interior, Bureau of Land Management or by a decree of a Court of Law and/or that the corner points mentioned in lines 3, 4 and 5 above were in conformance with the rules of the Michigan Board of Land Surveyors or by a Decree of a Court of Law, established, re-established, monumented, re-monumented, recovered, found as pressed below:

NOTE: Not more than 4 corners, all in the same town and range, may be recorded on this certificate.

Description of original monument and accessories and/or subsequent restoration:

J-13) Post set by Mullett in 1839.
Birch 10" N47°E .20 (13.20')
Tamarack 8" N35°W .33 (21.78')

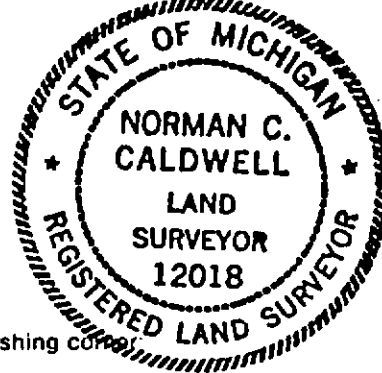

Description of corner evidence found and/or method applied in restoring or reestablishing corner:

J-13) LaGuire, 1934, fnd. orig. post, placed pipe & conc. block mon., verified by orig. BTs.
N68°E 78.5' 12" Cedar
N64°W 34.3' 4" W. Birch
C.E. Ostling, LS 12026, fnd. mon. in Dec. of 1961 & utilized for "RED. DOG" boundary.
Arleth, LS 21266, fnd. mon. April 26, 1978. Survey rec. in L 168, pg 221

Description of monument for corner and accessories established to perpetuate locating the position of the corner:

J-13) Standard 1/4 cor. Sec. 35, T27N-R1W
Fnd. 2" pipe in conc. block (LaGuire) per F. Arleth and C.E. Ostling surveys. And is accepted as a careful and faithful perpetuation of the position of the original corner.
North 1' Carsonite Witness Post S45°E 1.0' steel fence post
N70°E 78.5' 16" Cedar (old BT) (R)
S30°E 84.9' 16" Twin Cedar
S35°W 66.6' 8" Spruce
N20°W 57.5' 12" W. Birch

Prepared by Norman C. Caldwell Date April 26, 1990

Surveyor's Michigan License No. 12018