

LAND CORNER RECORDATION CERTIFICATE
Filing Requirement of Act 74, Mich. P.A. 1970

STATE OF MICHIGAN
COUNTY OF CRAWFORD

FILED FOR RECORD THIS

6th DAY OF June 19 90
9:30 am pm, IN LIBER 2
PAGE 369.

Elizabeth A. Wieland
Register of Deeds

Register of Deeds Stamp & File Number

or corners in _____

_____ Crawford _____ Located In: _____ Corner Code: 11

(County)

Public Land Survey T 27N R 1W _____ K-8 _____

T _____ R _____

T _____ R _____

T _____ R _____

Property Controlling S _____ T _____ R _____

In Section S _____ T _____ R _____

Miscellaneous S _____ T _____ R _____

Property in Sec. S _____ T _____ R _____

Lot No. _____, Recorded Plat _____

Private Claims _____

	A	B	C	D	E	F	G	H	I	J	K	L	M
2	6		5		4		3		2		1		
3													
4	7		8		9		10		11		12		
5													
6	18		17		16		15		14		13		
7													
8	19		20		21		22		23		24		
9													
10	30		29		28		27		26		25		
11													
12	31		32		33		34		35		36		
13													

Norman C. Caldwell a field survey on March, 19 90,
hereby certify that under requirements of P.A. 74, Michigan P.A. of 1970, the corner points mentioned
lines 1 and 2 above were in conformance with regulations and rules therefore as required in the
current manual of survey instructions of the United States Department of the Interior, Bureau of Land
management or by a decree of a Court of Law and/or that the corner points mentioned in lines 3, 4 and 5
above were in conformance with the rules of the Michigan Board of Land Surveyors or by a Decree of a
Court of Law; established, re-established, monumented, re-monumented, recovered, found as
expressed below:


NOTE: Not more than 4 corners, all in the same town and range, may be recorded
on this certificate.

Description of original monument and accessories and/or subsequent restoration:

- (K-8) Post set by Pettibone, July 19, 1852.
Spruce Pine 5" N46°W .06 (3.96')
- Spruce Pine 6" N87°E .33 (21.78')

Description of corner evidence found and/or method applied in restoring or reestablishing corner:

- (K-8) LaGuire, 1934, placed pipe & conc. block mon. by proportion.

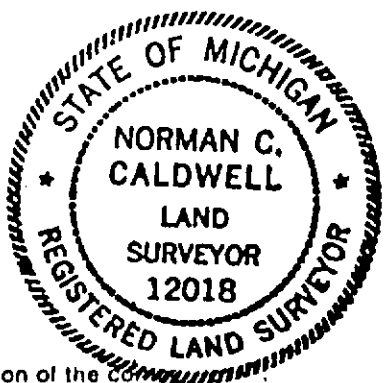

Description of monument for corner and accessories established to perpetuate localing the position of the corner:

- (K-8) 1/4 cor. 23&24, T27N-R1W
Replaced 1 1/2" pipe & conc. block, by LaGuire, which was fnd, lying
at E. edge of rd. It appears to have been removed by recent road ditch
improve. (Cor. is in ditch bottom). Accepted as a careful & faithful
reestablishment of the position of the orig. corner.
North 0.5' Carsonite Witness Post N75°E 13.5' old BT stump
N10°W 144.2' P. Pole S37°E 49.1' old BT stump
S10°W 163.9' P. Pole
S80°E 32.2' 10" J. Pine

Witnessed by *Norman C. Caldwell* Date April 26, 1990

Surveyor's Michigan License No. 12018