

LAND CORNER RECORDATION CERTIFICATE  
Filing Requirement of Act 74, Mich. P.A. 1970

STATE OF MICHIGAN  
COUNTY OF CRAWFORD

corners in  
Crawford (County) Located In: Corner Code #/

Public Land Survey T 27N R 1W K-10  
T R  
T R  
T R

Property Controlling S T R  
in Section S T R  
Miscellaneous S T R  
Property in Sec. S T R

FILED FOR RECORD THIS  
6th DAY OF June 1990 AT  
9:30 am pm, IN LIBER 2  
PAGE 371  
Elizabeth Wisland  
Register of Deeds

Register of Deeds Stamp & File Number

Lot No. \_\_\_\_\_, Recorded Plat \_\_\_\_\_  
Private Claims \_\_\_\_\_

	A	B	C	D	E	F	G	H	I	J	K	L	M
2	6	5	4	3	2	1							
3													
4	7	8	9	10	11	12							
5													
6	18	17	16	15	14	13							
7													
8	19	20	21	22	23	24							
9													
10	30	29	28	27	26	25							
11													
12	31	32	33	34	35	36							
13													

Norman C. Caldwell in a field survey on March, 1990  
I hereby certify that under requirements of P.A. 74, Michigan P.A. of 1970, the corner points mentioned in lines 1 and 2 above were in conformance with regulations and rules therefore as required in the current manual of survey instructions of the United States Department of the Interior, Bureau of Land Management or by a decree of a Court of Law and/or that the corner points mentioned in lines 3, 4 and 5 above were in conformance with the rules of the Michigan Board of Land Surveyors or by a Decree of a Court of Law; established, re-established, monumented, re-monumented, recovered, found as pressed below:


NOTE: Not more than 4 corners, all in the same town and range, may be recorded on this certificate.

Description of original monument and accessories and/or subsequent restoration:

K-10) Post set by Pettibone, July 19, 1852.  
W. Pine 7" S62°W .09 1/2 (6.27')  
Poplar 8" N32°E .09 (5.94')

Description of corner evidence found and/or method applied in restoring or reestablishing corner:

K-10) LaGuire, 1934, placed pipe & conc. block mon.  
K.J. Ostling, LS 10068, fnd. mon. & replaced w/DNR pipe & cap 9-5-72  
N34°W 28.6' 10" J. Pine  
S22°W 37.5' 4" R. Pine  
rec. in L 1, pg 14  
Hughes, LS 20706, fnd. DNR mon. Dec. 7, 1988  
N34°W 28.6' 10" J. Pine  
N22°W 37.5' 4" R. Pine  
S73°W 62.51' 7" R. Pine  
rec. in L 2, pg 305

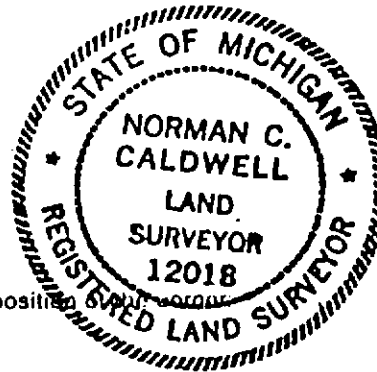

Description of monument for corner and accessories established to perpetuate locating the position:

K-10) 1/4 cor. 25&26, T27N-R1W  
Fnd. DNR pipe & cap, which replaced LaGuire 2" pipe in conc. block, per record in L 1, pg 14 & L 2, pg 305.  
Accepted as a careful & faithful reestablishment of the position of the original corner.  
North 1' Carsonite Witness Post N80°E 78.0' 18" R. Pine  
N34°W 28.9' 12" J. Pine (R)  
S22°W 37.5' 6" R. Pine (R) (recorded as N22°W)  
S73°W 62.4' 12" R. Pine (R)

Recorded by Norman C. Caldwell Date April 26, 1990  
Surveyor's Michigan License No. 12018