

LAND CORNER RECORDATION CERTIFICATE  
Filing Requirement of Act 74, Mich. P.A. 1970

STATE OF MICHIGAN  
COUNTY OF CRAWFORD

corners in

—Crawford— Located In: Corner Code :#

Public Land Survey T27N R 1W M-10

T R

T R

T R

Property Controlling S T R

in Section S T R

Miscellaneous S T R

Property in Sec. S T R

FILED FOR RECORD FILE  
6th DAY OF June 1990 at  
9:30 am, IN LIBER 2  
PAGE 382.  
*Elizabeth A. Wiklund*  
Register of Deeds

Register of Deeds Stamp & File Number

Lot No. \_\_\_\_\_, Recorded Plat \_\_\_\_\_  
Private Claims \_\_\_\_\_

	A	B	C	D	E	F	G	H	I	J	K	L	M
2	6	5	4	3	2	1							
3													
4	7	8	9	10	11	12							
5													
6	13	17	16	15	14	13							
7													
8	19	20	21	22	23	24							
9													
10	30	29	28	27	26	25							
11													
12	31	32	33	34	35	36							
13													

Norman C. Caldwell a field survey on March 19 90  
hereby certify that under requirements of P.A. 74, Michigan P.A. of 1970, the corner points mentioned in lines 1 and 2 above were in conformance with regulations and rules therefore as required in the present manual of survey instructions of the United States Department of the Interior, Bureau of Land Management or by a decree of a Court of Law and/or that the corner points mentioned in lines 3, 4 and 5 above were in conformance with the rules of the Michigan Board of Land Surveyors or by a Decree of a Court of Law; established, re-established, monumented, re-monumented, recovered, found as pressed below:

NOTE: Not more than 4 corners, all in the same town and range, may be recorded on this certificate.

Description of original monument and accessories and/or subsequent restoration:

M-10) Post set by Hodgson & Sibley, May 18, 1839.  
Maple 6" N70°W .14 (9.24')  
Pine 14" S34°W .50 (33.00')

Description of corner evidence found and/or method applied in restoring or reestablishing corner:


M-10) LaGuire, 1934, fnd. a post, but no trees  
K.J. Ostling, LS 10068, placed DNR pipe & cap by proportion 8-28-72 L 1 p16  
S66°W 19.1' 2" Spruce  
N45°W 96.8' 15" R. Pine  
Hughes, LS 20706, fnd. DNR pipe, placed 3/4" bar. Dec. 7, 1988.  
S88°W 43.21' 12" Spruce  
N73°E 21.96' 6" Spruce  
N75°W 96.8' 15" R. Pine  
rec. in L 2, pg 305

Description of monument for corner and accessories established to perpetuate locating the position of the corner:

M-10) Stand. 1/4 cor. 25, T27N-R1W  
Fnd. record 3/4" bar near CL N-S fireline/snowmobile trail, replaced with record DNR pipe. Accepted as the best available evidence of the position of the orig. corner.  
West 5' Carsonite Witness Post  
N70°E 21.8' 5" Spruce (R)  
S30°E 24.4' 6" Spruce  
S65°W 19.6' 4" Spruce (old BT)  
S85°W 43.3' 8" Spruce (R)

Witnessed by *Norman C. Caldwell*  
Surveyor's Michigan License No. 12018

Date APR 11 26, 1990

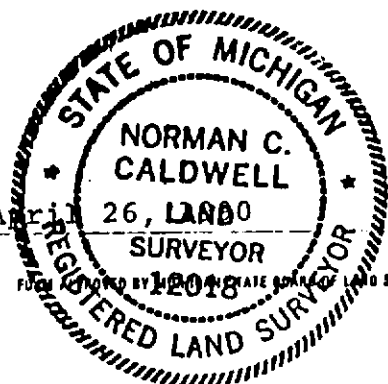

REGISTERED LAND SURVEYOR  
REVISED JAN. 1983