

LAND CORNER RECORDATION CERTIFICATE  
Filing Requirement of Act 74, Mich. P.A. 1970

or corners in  
Crawford Located In: Corner Code: M-11  
 Public Land Survey T 27N R 1W  
 T R  
 T R  
 T R  
 Property Controlling S T R  
 in Section S T R  
 Miscellaneous S T R  
 Property in Sec. S T R

STATE OF MICHIGAN  
COUNTY OF CRAWFORD

FILED FOR RECORD THIS  
6th DAY OF June 1990 AT  
9:30 AM in LIBER 2  
 PAGE 383.

*Richard A. Wilansky*  
 Register of Deeds

Register of Deeds Stamp & File Number

Lot No. \_\_\_\_\_, Recorded Plat \_\_\_\_\_  
 Private Claims \_\_\_\_\_

	A	B	C	D	E	F	G	H	I	J	K	L	M
2	6	5	4	3	2								
3													
4	7	8	9	10	11	12							
5													
6	16	17	16	15	14	13							
7													
8	18	20	21	22	23	24							
9													
10	30	29	28	27	26	25							
11													
12	31	32	33	34	35	36							
13													

Norman C. Caldwell field survey on March, 1990,  
 hereby certify that under requirements of P.A. 74, Michigan P.A. of 1970, the corner points mentioned  
 lines 1 and 2 above were in conformance with regulations and rules therefore as required in the  
 current manual of survey instructions of the United States Department of the Interior, Bureau of Land  
 Management or by a decree of a Court of Law and/or that the corner points mentioned in lines 3, 4 and 5  
 above were in conformance with the rules of the Michigan Board of Land Surveyors or by a Decree of a  
 Court of Law; established, re-established, monumented, re-monumented, recovered, found as  
 pressed below:

NOTE: Not more than 4 corners, all in the same town and range, may be recorded  
 on this certificate.

Description of original monument and accessories and/or subsequent restoration:

(M-11) Post set by Hodgson & Sibley, May 18, 1839.  
 Pine 10" S49°W .05 (3.30')  
 Pine 8" N61°W .20 (13.20')

Description of corner evidence found and/or method applied in restoring or reestablishing corner:


(M-11) LaGuire, 1934, placed pipe & conc. block mon. from orig. BTs.  
 K.J. Ostling, LS 10008, fnd. mon. & fnd. U.S. BT 8-28-72  
 S63°E 19.3' 9" Poplar  
 S29°E 66.0' 7" Maple  
 S53°W 84.1' 12" R Pine  
 rec. in L 1, pg 16

Description of monument for corner and accessories established to perpetuate locating the position of the corner:

(M-11) Stand. cor. 25436, T27N-R1W  
 Fnd. 1 1/2" pipe in conc. by LaGuire, 3' E. of W. edge of trail.  
 And is accepted as a careful & faithful perpetuation of the position  
 of the original corner.  
 North 0.5' Carsonite Witness Post  
 S88°W 9.3' Fe. cor. post  
 S45°W 65.2' 10" J. Pine  
 S25°E 66.8' 14" Maple (old BT)

Witnessed by Norman C. Caldwell  
 Surveyor's Michigan License No. 12018

Date June 6, 1990

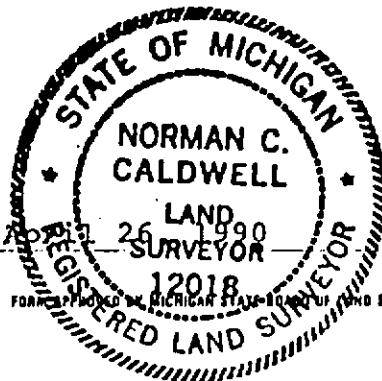

FOR APPROVAL BY MICHIGAN STATE BOARD OF LAND SURVEYORS, JAN. 26, 1971  
 REVISED MAY 14, 1975  
 REVISED JAN., 1983