

SURVEY & REMONUMENTATION

APR 07 1998

LAND CORNER RECORDATION CERTIFICATE
Filing Requirement of Act 74, Mich. P.A. 1970

For corners in SECTION

Crawford (County) Located In: Corner Code #

1. Public Land Survey T 26N R 2W A-1
 T 27N R 2W A-13
 T 27N R 3W M-13
 T 36N R 3W A-13

2. Property Controlling S T R
 In Section S T R

3. Miscellaneous S T R
 Property in Sec. S T R

4. Lot No. , Recorded Plat

5. Private Claims LIBER

STATE OF MICHIGAN
CRAWFORD COUNTY
RECORDED

19 DEC 97 2:36 P.M.

SANDRA MOORE
REGISTER OF DEEDS

Register of Deeds Stamp & File Number

3 PAGE 281

I, Marvin E. Myers, in a field survey on 27 MAY, 1997 do hereby state that under requirements of P.A. 74, Michigan P.A. of 1970, the corner points mentioned in lines 1 and 2 above were in conformance with regulations and rules therefore as required in the current manual of survey instructions of the United States Department of the Interior, Bureau of Land Management or by a decree of a Court of Law and /or that the corner points mentioned in lines 3, 4 and 5 above were in conformance with the rules of the Michigan Board of Land Surveyors or by a Decree of a Court of Law; established, re-established, monumented, recovered, found as expressed below:

NOTE: Not more than 2 corners, all in the same town and range, may be recorded on this certificate.

A. Description of original monument and accessories and/or subsequent restoration:

G.L.O. 1955 George D. Henning R.L.S.
 15 June 1852 Unrecorded Survey Sec.6 T26N R2W
 Darwin A. Pettibone D.S. Restored from stumps of original U.S.
 Mon: Post' witnesses
 Wit: 24" Pine S71°W 1.00 links Mon: 3/4" square bar in blacktop 9' N.
 18" Yellow Pine N80°E 1.29' links' of centerline
 12" White Pine N18°W 0.94 links Wit: 4" Jack Pine N58°W 58.1
 8" Jack Pine N41°E 37.00'
 7" Jack Pine S31°W 62.0'

	A	B	C	D	E	F	G	H	I	J	K	L	M
1													
2	6		5		4		3		2		1		
3													
4	7		8		9		10		11		12		
5													
6	18		17		16		15		14		13		
7													
8	19		20		21		22		23		24		
9													
10	30		29		28		27		26		25		
11													
12	31		32		33		34		35		36		
13													

Robert T. Ostling R.L.S.#5133
 Liber 1 Page 59, 14 August 1959
 Plat of Ausable Trails
 Mon: 3/4" Iron in pavement
 Wit: none provided

Eugene Ostling R.L.S.#12026
 Unrecorded survey, 4 Sept 1971
 Mon: 3/4" square iron
 Wit: none provided

Norman F. Parker R.L.S.#16939
 Liber 148 Page 07, 26 Sept 1975
 Mon: no description provided
 Wit: none provided


Norman F. Parker R.L.S.#12026
 Unrecorded survey 29 Dec 1986
 Mon: no description provided
 Wit: none provided

B. Description of corner evidence found and/or method applied in restoring or reestablishing corner:
 Found Rail Road spike flush with the asphalt surface 8.5' north of centerline. Verified position by measurement to corners East and West. Accepted position as a perpetuation of the original government Corner, replaced railroad spike in exact location with standard County Monument in pavement monument box.

C. Description of monument for corner and accessories established to perpetuate locating the position of the corner:
 Mon - Standard Crawford County monument in Pavement Monument box.
 Wit: Spike in Southeast side Utility Pole S53°W 60.60'
 Set spike in West side 13" Red Pine S36°W 76.90'
 Set spike in East side 8" White Pine S38°E 87.60'
 Set spike in 8" Jack Pine N20°W 43.63'

CRAWFORD COUNTY
PEER GROUP APPROVAL
 DATE OCT 16, 1997

Marvin E. Myers
 Marvin E. Myers, P.S.
 County Surveyor

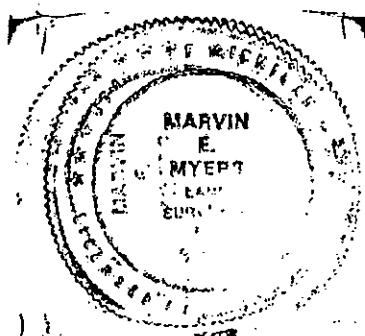

Signed by Marvin E. Myers
 Surveyor's Michigan License No. 31600

Date Dec 15, 1997