

APR 07 1998

SECTION

LAND CORNER RECORDATION CERTIFICATE
Filing Requirement of Act 74, Mich. P.A. 1970

For corners in

| | | |
|---------------------------------------|---|--------------------|
| <u>Crawford</u> (County) | Located In: | Corner Code # |
| 1. Public Land Survey | T <u>26NR 2W</u> T <u>27N R 2W</u> T _____ R _____ T _____ R _____ | C-1 <u>C-13</u> |
| 2. Property Controlling in Section | S _____ T _____ R _____ S _____ T _____ R _____ | _____ |
| 3. Miscellaneous Property in Sec. | S _____ T _____ R _____ S _____ T _____ R _____ | _____ |
| 4. Lot No. _____, Recorded Plat _____ | | _____ |
| 5. Private Claims _____ | | _____ |

STATE OF MICHIGAN
CRAWFORD COUNTY
RECORDED
19 DEC 97 2:36 P.M.
SANDRA MOORE
REGISTER OF DEEDS
Register of Deeds Stamp & File Number

LIBER

3 PAGE 283

I, Marvin E. Myers, in a field survey on 27 MAY, 1997 do hereby state that under requirements of P.A. 74, Michigan P.A. of 1970, the corner points mentioned in lines 1 and 2 above were in conformance with regulations and rules therefore as required in the current manual of survey instructions of the United States Department of the Interior, Bureau of Land Management or by a decree of a Court of Law and /or that the corner points mentioned in lines 3, 4 and 5 above were in conformance with the rules of the Michigan Board of Land Surveyors or by a Decree of a Court of Law; established, re-established, monumented, recovered, found as expressed below:

| | A | B | C | D | E | F | G | H | I | J | K | L |
|----|----|---|----|---|----|---|----|---|----|---|---|---|
| 1 | | | | | | | | | | | | |
| 2 | 6 | | 5 | | 4 | | 3 | | 2 | | | |
| 3 | | | | | | | | | | | | |
| 4 | 7 | | 8 | | 9 | | 10 | | 11 | | | |
| 5 | | | | | | | | | | | | |
| 6 | 18 | | 17 | | 16 | | 15 | | 14 | | | |
| 7 | | | | | | | | | | | | |
| 8 | 19 | | 20 | | 21 | | 22 | | 23 | | | |
| 9 | | | | | | | | | | | | |
| 10 | 30 | | 29 | | 28 | | 27 | | 26 | | | |
| 11 | | | | | | | | | | | | |
| 12 | 31 | | 32 | | 33 | | 34 | | 35 | | | |
| 13 | | | | | | | | | | | | |

NOTE: Not more than 2 corners, all in the same town and range, may be recorded on this certificate.

A. Description of original monument and accessories and/or subsequent restoration:

G.L.O.
15 June 1852
Darwin A. Pettibone D.S.
Mon: Post
Wit: 8" Pine N28°E 38 links
8" Pine N70°W 55 links

George D. Henning R.L.S.
Unrecorded Survey Sec.6 T26N R2W 1955
Mon: 1" x 18" Iron in corner 2' North of centerline of road
Wit: 6" Jack Pine S37°W 56.7'
8" Jack Pine S48 1/2°E 63.5'
10" Jack Pine N25 1/2°W 51.2'
8" Jack Pine N47 1/2°W104.5'


George D. Henning R.L.S.
Unrecorded Survey Sec.5 T26N R2W 1955
Mon: 1" x 18" Iron in corner 2' North of centerline of road
Wit: 6" Jack Pine S37°W 56.7'
8" Jack Pine S48 1/2°E 63.5'
10" Jack Pine N25 1/2°W 51.2'
8" Jack Pine N47 1/2°W104.5'

**CRAWFORD COUNTY
PEER GROUP APPROVAL
DATE OCT 16, 1997**

Marvin E. Myers
**Marvin E. Myers, P.S.
County Surveyor**

B. Description of corner evidence found and/or method applied in restoring or reestablishing corner:
Found Rail Road spike flush with surface of asphalt. Verified position by measurement to other corners. Accepted as the best available evidence of the position of the Original Government Corner. Replaced in exact location with Standard Crawford County Monument in pavement monument box.

C. Description of monument for corner and accessories established to perpetuate locating the position of the corner:
Mon - Standard Crawford County Monument in pavement monument box.
Wit: Spike in South face Utility Pole S81°W 122.82'
Set spike in East face 8" Jack Pine S30°W 64.18'
Set spike in Southwest face 6" Jack Pine S20°E 72.80'
Set spike in Northwest face 4" Jack Pine S40°E 93.50'

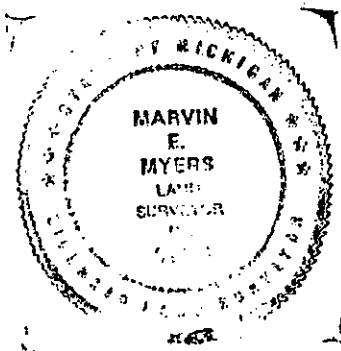

Signed by *Marvin E. Myers*
Surveyor's Michigan License No. 31600

Date Dec 15, 1997