

LAND CORNER RECORDATION CERTIFICATE

FILING REQUIREMENT OF ACT 74, MICH. P.A.1970

FOR CORNERS OF --:	LOCATED IN --:	CORNER CODE NUMBER
1. PUBLIC LAND SURVEY _____	T. 27 N. R. 2 W. ●	I-9; I-10; <u>J-9</u>
2. PROPERTY CONTROLLING IN SECTION 26	T. 27 N. R. 2 W. ●	3
3. MISCELLANEOUS PROPERTY IN SECTION _____	T. _____ N. S. R. _____ E. W.	
4. LOT NO. _____, RECORDED PLAT _____		
5. PRIVATE CLAIMS _____		

REGISTER OF DEEDS STAMP AND FILING NUMBER

I, Kenneth J. Ostling, do hereby certify that under requirements of P.A. 74, Michigan P.A. of 1970, the corner points mentioned in lines 1 and 2 above were, in a field survey on September 20, 1978, established, re-established, monumented, re-monumented, recovered or restored as expressed below and in conformance with regulations and rules therefore as required in the current manual of survey instructions of the United States Department of the Interior, Bureau of Land Management or by a decree of a court of law. Furthermore, that the corner points mentioned in lines 3, 4 and 5 above were, in a field survey on _____, 19____, found, recovered, restored, established or re-established as expressed below and in conformance with the rules of the Michigan State Board of Registration for Land Surveyors or, by a Decree of a Court of law:

A. - ~~Description of original monument and accessories and/or subsequent restoration~~
 C. (continued)

Set 5/8" Rod w/RLS Cap & Cedar Post
 5" W. Oak S17°W 27.24
 5" Oak S84°W 17.35


- B. Description of corner evidence found and/or method applied in restoring or re-establishing corner:
- I-9 Found 1/2" iron bar in place as previously located or established by N. Parker. Fits 1/4 line fence south and 1/4 corner east.
 - I-10 Set corner by proportionate measurement, midpoint on line, between section corners. Falls in line with old fence east, on west edge of N-S truck trail.
 - J-9 Corner previously restored from Schaaf survey in 1951 when USBT could be identified. Original monument damaged by traffic; new monument placed in this survey.
 - 3 Set corner by standard survey procedure for the subdivision of sections.

C. Description of monument for corner and accessories established to perpetuate locating the position of the corner:

I-9	I-10	J-9
Left 1/2" rod w/RLS Cap (16939) in place	Set DNR Mon. & cedar post	Set new DNR Monument
4" W. Oak S48°W 59.9	5" R. Pine N79°W 24.1	16" R. Pine S51°W 84.95
12" Oak S32°E 92.05	18" Oak N06°W 43.38	6" W. Oak N49°W 75.38
Set cedar guard post		8" Oak Stump N46°W 39.45

SIGNED BY Kenneth J. Ostling
 SURVEYOR'S MICHIGAN REGISTRATION NO. 10068

DATE 11-2-78

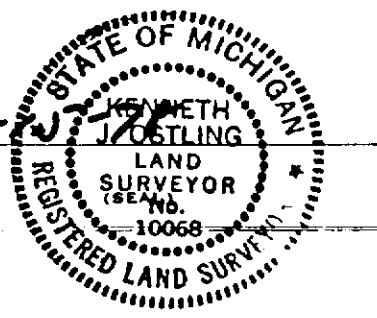

FOR STATE AND UNITED STATES AGENCIES:

SIGNED BY _____ DATE _____
CHIEF OF SURVEY PARTY

APPROVED AND SIGNED BY _____ DATE _____
MICHIGAN REGISTERED LAND SURVEYOR

SURVEYOR'S MICHIGAN REGISTRATION NO. _____ CRAWFORD COUNTY