

LAND CORNER RECORDATION CERTIFICATE

FILING REQUIREMENT OF ACT 74, MICH. P.A.1970

FOR CORNERS OF--:	LOCATED IN--:	CORNER CODE NUMBER
1. PUBLIC LAND SURVEY	28 T. 27 N. R. 2 W.	G-10, G-11, F-11, E-11
2. PROPERTY CONTROLLING IN SECTION	T. _____ N. S. R. _____ E. W.	_____
3. MISCELLANEOUS PROPERTY IN SECTION	T. _____ N. S. R. _____ E. W.	_____
4. LOT NO. _____, RECORDED PLAT _____		
5. PRIVATE CLAIMS _____		

REGISTER OF DEEDS STAMP AND
 FILING NUMBER _____

I, Kenneth J. Ostling, do hereby certify that under requirements of P.A. 74, Michigan P.A. of 1970, the corner points mentioned in lines 1 and 2 above were, in a field survey on June 23, 1981, established, re-established, monumented, re-monumented, recovered or restored as expressed below and in conformance with regulations and rules therefore as required in the current manual of survey instructions of the United States Department of the Interior, Bureau of Land Management or by a decree of a court of law. Furthermore, that the corner points mentioned in lines 3, 4 and 5 above were, in a field survey on _____, 19____, found, recovered, restored, established or re-established as expressed below and in conformance with the rules of the Michigan State Board of Registration for Land Surveyors or, by a Decree of a Court of law:

A. Description of original monument and accessories and/or subsequent restoration:

B. Description of corner evidence found and/or method applied in restoring or re-establishing corner:
 G-10 Set by proportionate measurement between section corners.
 G-11 Fd. 2" iron pipe at road intersection, as restored in 1930's survey by M. Schaaf, RLS
 F-11 Set corner by proportionate measurement. No previous monument found.
 E-11 Fd. 2" pipe at rd. intersection, as restored in 1930's survey by M. Schaaf, R.L.S.

C. Description of monument for corner and accessories established to perpetuate locating the position of the corner:

<p>G-10</p> <p>Set DNR Mon. 14" R. Pine N32°W 30.3ft. (1/4,NBT) 9" J. Pine S39°W 22.5ft. (1/4,NBT)</p>	<p>G-11</p> <p>Left 2" iron pipe in place 11" R. Oak S57°E 20.5 ft. 8" R. Oak S49°W 21.0 Ft.</p>
<p>F-11</p> <p>Set DNR Mon. 9" J. Pine N57°W 20.4 ft. 7" J. Pine N9°E 17.2 ft.</p>	<p>E-11</p> <p>6" J. Pine S28°W 34.7 ft. 12" R. Oak N54°W 30.3 ft. LEFT 2" IRON PIPE IN PLACE</p>

SIGNED BY Kenneth Ostling DATE 8/20/81


SURVEYOR'S MICHIGAN REGISTRATION NO. 10068

FOR STATE AND UNITED STATES AGENCIES:

SIGNED BY _____ DATE _____

APPROVED AND SIGNED BY _____ DATE _____

CHIEF OF SURVEY PARTY MICHIGAN REGISTERED LAND SURVEYOR

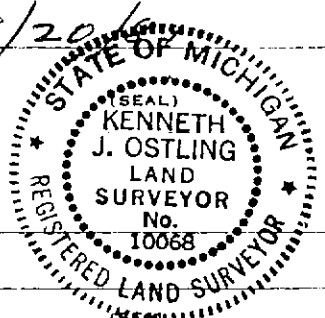

SURVEYOR'S MICHIGAN REGISTRATION NO. _____ CRAWFORD COUNTY