

LAND CORNER RECORDATION CERTIFICATE

FILING REQUIREMENT OF ACT 74, MICH. P.A.1970

FOR CORNERS OF--:	LOCATED IN--:	CORNER CODE NUMBER
1. PUBLIC LAND SURVEY	28 T. 27 N. R. 2 W.	E-10, F-9, E-9, G-9
2. PROPERTY CONTROLLING IN SECTION	T. S., R. E. W.	
3. MISCELLANEOUS PROPERTY IN SECTION	T. S., R. E. W.	
4. LOT NO. _____, RECORDED PLAT _____		
5. PRIVATE CLAIMS _____		

REGISTER OF DEEDS STAMP AND
FILING NUMBER

I, Kenneth J. Ostling, do hereby certify that under requirements of P.A. 74, Michigan P.A. of 1970, the corner points mentioned in lines 1 and 2 above were, in a field survey on June 18, 1981, established, re-established, monumented, re-monumented, recovered or restored as expressed below and in conformance with regulations and rules therefore as required in the current manual of survey instructions of the United States Department of the Interior, Bureau of Land Management or by a decree of a court of law. Furthermore, that the corner points mentioned in lines 3, 4 and 5 above were, in a field survey on _____, 19____, found, recovered, restored, established or re-established as expressed below and in conformance with the rules of the Michigan State Board of Registration for Land Surveyors or, by a Decree of a Court of law:

A. Description of original monument and accessories and/or subsequent restoration:

B. Description of corner evidence found and/or method applied in restoring or re-establishing corner:

- E-10 Set corner by proportionate measurement between section corners. No previous monument found.
- F-9 Fd. 2" pipe at corner as established in previous survey by Marcus Schaaf, R.L.S. Fd. and witnessed in 1951 survey by D.C. DeLaMater.
- E-9 Replaced corner as found and restored in 1950 survey by this Dept. previously established in 1930's survey by M. Schaaf, R.L.S.
- G-9 Found corner as established in 1930's by M. Schaaf, R.L.S.

C. Description of monument for corner and accessories established to perpetuate locating the position of the corner:

<p style="text-align: center;">E-10</p> <p>Set DNR mon, below sur.</p> <p>14" J. Pine S45°E 16.8 ft. (1/4,NBT)</p> <p>10" R. Oak N58°E 26.6 ft. (1/4,NBT)</p>	<p style="text-align: center;">F-9</p> <p>Lt. 2" pipe w/conc in place</p> <p>9" Jack Pine S51°W 37.9 ft. (1/4,NBT)</p> <p>7" Jack Pine S55°E 35.7 ft. (1/4,NBT)</p>
<p style="text-align: center;">G-9</p> <p>Left 2" iron pipe w/conc. in place</p> <p>7" R. Oak S61°W 29.3 Ft. (S28,NBT)</p> <p>5" J. Pine N79°W 30.0 ft. (S21,NBT)</p>	<p style="text-align: center;">E-9</p> <p>Set DNR mon.</p> <p>4" R. Maple N60°E 30.7 ft. (S21,NBT)</p> <p>8" R. Oak S31°W 62.9 ft. (S29,NBT)</p> <p>* R. Oak S60°E 17.8'</p> <p>* R. Oak N34°W 23.8' (stump)</p> <p>* 1950 NBTs</p>

SIGNED BY Kenneth J. Ostling DATE 8/20/81

SURVEYOR'S MICHIGAN REGISTRATION NO. 10068


FOR STATE AND UNITED STATES AGENCIES:

SIGNED BY _____ DATE _____

APPROVED AND SIGNED BY _____ DATE _____

CHIEF OF SURVEY PARTY

MICHIGAN REGISTERED LAND SURVEYOR

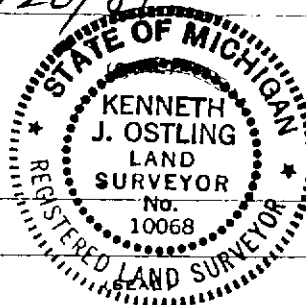

SURVEYOR'S MICHIGAN REGISTRATION NO. _____

CRAWFORD COUNTY