

LAND CORNER RECORDATION CERTIFICATE

FILING REQUIREMENT OF ACT 74, MICH. P.A.1970

FOR CORNERS OF--	LOCATED IN--	CORNER CODE NUMBER
1. PUBLIC LAND SURVEY	T 27 N R 3 W	I-1; I-2; J-1; K-2
2. PROPERTY CONTROLLING IN SECTION	N R W	
3. MISCELLANEOUS PROPERTY IN SECTION	N R W	
4. LOT NO. _____, RECORDED PLAT _____		
5. PRIVATE CLAIMS		

REGISTER OF DEEDS STAMP AND FILING NUMBER _____

I, **Kenneth J. Ostling**, do hereby certify that under requirement of P.A. 74, Michigan P.A. of 1970, the corner points mentioned in lines 1 and 2 above were, in a field survey on **November 19**, 19**79**, established, re-established, monumented, re-monumented, recovered or restored as expressed below and in conformance with regulations and rules therefore as required in the current manual of survey instructions of the United States Department of the Interior, Bureau of Land Management or by a decree of a court of law. Furthermore, that the corner points mentioned in lines 3, 4 and 5 above were, in a field survey on _____, 19____ found, recovered, restored, established or re-established as expressed below and in conformance with the rules of the Michigan State Board of Registration for Land Surveyors or, by a Decree of a Court of law:

A - Description of original monument and accessories and of video point established
C. (continued)

	K-2	
	Set DNR Monument	
12" Cedar	S21°W	4.20
12" Cedar	N20°W	28.15
12" Cedar	N45°E	21.03


- B. Description of corner evidence found and of method applied in restoring or re-establishing corner.
- 1 Fd. 1" bar during previous surveys in this area. Used in adjacent surveys and to control surveys to south.
 - 2 Set corner relative to previous subdivision and monumentation in Sec. 2. Falls within 5' of proportionate measurement for 2 miles north and south.
 - 1 Set corner by proportionate measurement between section corners. Any previous evidence gone.
 - 2 Restored corner from witnesses of record by N. Parker.

C. Description of monument for corner and accessories established to perpetuate locating the position of the corner.

I-1	I-2	J-1
Fd. 1" Bar in Conc. Raised to Surf. with 5/8" Rerod w/RLS Cap	Set 5/8" Rod w/RLS Cap	Set DNR Monument
10" Maple S84°W 48.85	12" R. Pine S47°E 36.22	7" R. Pine S70°E 100.85
5" Maple S27°W 113.04	12" R. Pine N51°E 39.05	8" Maple in Clump N10°W 35.07
	Cedar Post East	Set Cedar Post at Monument

SIGNED BY *Kenneth J. Ostling*
 SURVEYORS MICHIGAN REGISTRATION NO 10068

DATE *12/1/79*

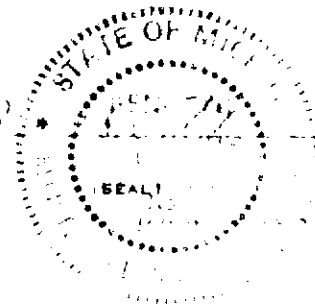

FOR STATE AND UNITED STATES AGENCIES

SIGNED BY _____
CHIEF OF SURVEY PARTY

DATE _____

APPROVED AND SIGNED BY _____
MICHIGAN REGISTERED LAND SURVEYOR

DATE _____

(SEAL)

SURVEYOR'S MICHIGAN REGISTRATION NO _____

CRAWFORD COUNTY