

# LAND CORNER RECORDATION CERTIFICATE

Filing Requirement of Act 74, Mich. PA 1970

For Corners In: Crawford Located In \_\_\_\_\_ Corner Code # \_\_\_\_\_  
(County)

1. Public Land Survey		T	<u>27N</u>	R	<u>3W</u>	A-9
		T	<u>27N</u>	R	<u>3W</u>	B-9
2. Property Controlling in Section	S	T		R		
	S	T		R		
3. Miscellaneous Property in Section	S	T		R		
	S	T		R		


4. Lot No: \_\_\_\_\_ Recorded Plat: \_\_\_\_\_

5. Private Claims: \_\_\_\_\_

I, Carl T. Kiiskila, in a field survey on September 27, 2004 do hereby state that under requirements of PA 74, Michigan PA of 1970, the corner points mentioned in lines 1 and 2 above were in conformance with regulations and rules therefore as required in the current manual of survey instructions of the United States Department of the Interior, Bureau of Land Management or by a decree of a Court of Law and/or that the corner points mentioned in lines 3, 4 and 5 above were in conformance with the rules of the Michigan Board of Land Surveyors or by a Decree of a Court of Law; established, re-established, monumented, recovered, found as expressed below:

**NOTE: Not more than 2 corners, all in the same town and range, may be recorded on this certificate.**

Register of Deeds Stamp & File Number

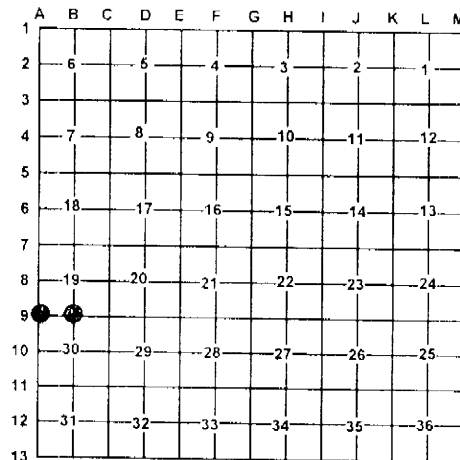

A. Description of original monument and accessories and/or subsequent restoration:

A-9 G.L.O. James H. Mullett 1839 set section post corner section 24 and 25 T.27N.,4W.  
Wit: Pine 8 N18°W 23 links  
Pine 8 S60°W 25 links

B-9 Addison P. Brewer 1859 set quarter section post  
Wit: Y. Pine 17 N22°E 18 links  
Y. Pine 16 S55°W 12 links

B. Description of corner evidence found and/or method applies in restoring or re-establishing corner:

A-9 Found 1 1/2" pipe possibly set by Marcus Schaaf R.L.S. #3104

B-9 Found 1 1/2" pipe accepted by local surveys in the area.

C. Description of monument for corner and accessories established to perpetuate locating the position of the corner:

A-9 Found 1 1/2" pipe  
Wit: 10" R. Pine N05°W 13.12'  
12" Oak S65°E 26.11'  
14" Oak S66°W 11.57'  
8" R. Pine S25°E 19.49'  
Blue Carsonite Post North 1'±

B-9 Found 1 1/2" pipe  
Wit: 3" Oak S40°W 17.59'  
5" Oak N38°W 19.00'  
3" Oak S05°W 23.30'  
10" Oak N70°E 127.32'  
Blue Carsonite Post North 1'±

Signed by: Carl T. Kiiskila  
Surveyor's Michigan License No.: 33981

Date: 10-6-04

