LAND CORNER RECORDATION CERTIFICATE

Filing Requirement of Act 74, Mich. PA 1970

For Corners In:
Crawford
(County)

		Located In		Corner Code #
1. Public Land Survey		T 27N	R 3W	C-11
		T 27N	R 3W	D-11
2. Property Controlling in Section	S	T	R	
	S	T	R	
3. Miscellaneous Property in Section	S	T	R	
	S	T	R	

Register of Deeds Stamp & File Number

4. Lot No: _____ Recorded Plat: _____

5. Private Claims: _____

I, Carl T. Kiiskila, in a field survey on September 27, 2004 do hereby state that under requirements of PA 74, Michigan PA of 1970, the corner points mentioned in lines 1 and 2 above were in conformance with regulations and rules therefore as required in the current manual of survey instructions of the United States Department of the Interior, Bureau of Land Management or by a decree of a Court of Law and/or that the corner points mentioned in lines 3, 4 and 5 above were in conformance with the rules of the Michigan Board of Land Surveyors or by a Decree of a Court of Law; established, re-established, monumented, recovered, found as expressed below:

NOTE: Not more than 2 corners, all in the same town and range, may be recorded on this certificate.

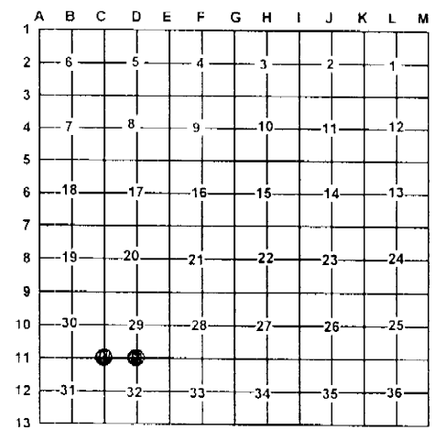

A. Description of original monument and accessories and/or subsequent restoration:

C-11 G.L.O. Addison P. Brewer Set post corner of sections 29, 30, 31, and 32.
Wit: W. Pine 24 N47°E 26 links
W. Pine 24 S19°W 76 links
Liber 2 Page 323 Marvin E. Myers L.S. #31600 (1990),
Found 1 ¼" Pipe Wit: Utility Pole N61°E 57.0'
5" J. Pine N22°E 31.8'
5" J. Pine N32°W 35.2'
East edge of Trail

D-11 G.L.O. Addison P. Brewer Set quarter section post
Wit: Maple 10 N70°E 16 links
Hemlock 8 S34°W 13 links

Kenneth Ostling L.S. #10068 1981 Found 1" bolt
Wit: Nail SE face P. Pole N50°E 43.3'
Nail SW face 8" J. Pine S50°E 62.72'
Nail NW face 7" J. Pine S42°W 25.7'
Nail W face P. Pole N16°W 33.4'

B. Description of corner evidence found and/or method applies in restoring or re-establishing corner:

C-11 Found 1 ½" iron pipe

D-11 Found 1" iron with 1 ½" hex head.

C. Description of monument for corner and accessories established to perpetuate locating the position of the corner:

C-11 Found 1 ½" iron pipe
Wit: P. Pole N62°E 57.13'
10" J. Pine N23°E 32.76'
10" R. Pine S46°E 35.42'
12" Maple S87°W 140.76'
Centerline of N-S trail West 5'±
Blue Carsonite post East 1'±

D-11 Found 1" iron with 1 ½" hex head
Wit: P. Pole N21°W 36.60'
P. Pole N51°E 43.28'
6" J. Pine S43°W 25.70
10" J. Pine Southeast 62.72'

Signed by: Carl T. Kiiskila Date: 10-6-04

Surveyor's Michigan License No.: 33981

STATE OF MICHIGAN
CARL KIISKILA
LAND SURVEYOR
No. 33981
LICENSED LAND SURVEYOR

FORM APPROVED BY MICHIGAN STATE BOARD OF PROFESSIONAL SURVEYORS JAN. 28, 1971
Revised May 14, 1975
Revised Jan. 1983
Revised Oct. 1995