

MAR 28 1999

LAND CORNER RECORDATION CERTIFICATE  
Filing Requirement of Act 74, Mich. P.A. 1970

SECTION

For corners in

Crawford  
(County)

Located In:

Corner Code #

1. Public Land Survey

T28NR4W H-13  
T27NR4W H-1 ✓

2. Property Controlling  
in Section

S T R

3. Miscellaneous  
Property in Sec.

S T R

S T R

4. Lot No. \_\_\_\_\_, Recorded Plat \_\_\_\_\_

5. Private Claims \_\_\_\_\_

I, James L. Schwandt, in a field survey on 10/15, 1998 to hereby certify that under requirements of P.A. 74, Michigan P.A. of 1970, the corner points mentioned in lines 1 and 2 above were in conformance with regulations and rules therefore as required in the current manual of survey instructions of the United States Department of the Interior, Bureau of Land Management or by a decree of a Court of Law and/or that the corner points mentioned in lines 3, 4 and 5 above were in conformance with the rules of the Michigan Board of Land Surveyors or by a Decree of a Court of Law; established, re-established, monumented, re-monumented, recovered, found as expressed below:

A. Description of original monument and accessories and/or subsequent restoration:

- 1.) H-13, T28N-R4W; G.L.O. James H. Mullett, 1839; Set Post; Beech 8", N10°W, 14 links; Hemlock 8", N29°E, 30 links.
- 2.) Kenneth J. Ostling, #10068, 1972-1974; Corner used in boundary retracement survey; No description of corner on survey.
- 3.) Norman F. Parker, #16939, 1984; Found 1/2" bar at fence corner; 8" Maple, N33°W, 20.8'; 10" Maple, S5°E, 21.5'; 12" Maple, N85°E, 23.2'.


B. Description of corner evidence found and/or method applied in restoring or reestablishing corner:

- 1.) Found 1/2" bar, fence corner is laying on the ground; Found P.K. nail and blaze, 8.0" Maple, N20°W, 21.20'; Found P.K. nail and blaze, 10.0" Maple, S5°E, 22.05'; Found P.K. nail and blaze, 12.0" Maple, N85°E, 23.0'; Found spike and blaze, 7.0" Maple, N55°W, 8.75'.

C. Description of monument for corner and accessories established to perpetuate locating the position of the corner:

Mon: Replaced 1/2" bar with Crawford County Monument, accepted as the best available evidence of the position of the original corner.

- Wit: P.K. nail and blaze, 8.0" Maple, N20°W, 21.20'  
 P.K. nail and blaze, 10.0" Maple, S5°E, 22.05'  
 P.K. nail and blaze, 12.0" Maple, N85°E, 23.00'  
 Spike and blaze, 7.0" Maple, N55°W, 8.75'

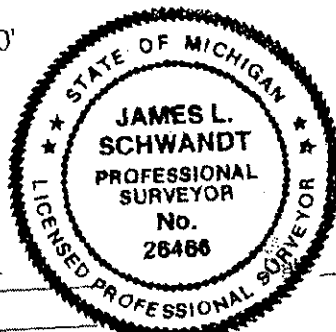

Signed by James L. Schwandt  
Surveyor's Michigan License No. 26466

STATE OF MICHIGAN  
CRAWFORD COUNTY  
RECORDED

31 DEC 98 9:39 A.M.

SANDRA MOORE  
REGISTER OF DEEDS

Register of Deeds Stamp & File Number

	A	B	C	D	E	F	G	H	I	J	K	L	M
1													
2	6		5		4		3		2		1		
3													
4	7		8		9		10		11		12		
5													
6	18		17		16		15		14		13		
7													
8	19		20		21		22		23		24		
9													
10	30		29		28		27		26		25		
11													
12	31		32		33		34		35		36		
13													

CRAWFORD COUNTY  
PEER GROUP APPROVAL  
DATE Dec 21, 1998

Marvin E. Myers  
Marvin E. Myers, P.S.  
County Surveyor  
10-15-98