

SECTION

LAND CORNER RECORDATION CERTIFICATE
Filing Requirement of Act 74, Mich. P.A. 1970

For corners in

Crawford
(County)

Located In:

Corner Code #

LIBER

3

PAGE 312

STATE OF MICHIGAN
CRAWFORD COUNTY
RECORDED

5 JAN 98 10:37 A.M.

SANDRA MOORE
REGISTER OF DEEDS

1. Public Land Survey

T28N R4W

T27N R4W

T R

T R

2. Property Controlling in Section

S T R

S T R

3. Miscellaneous Property in Sec.

S T R

S T R

L-13
L-1

4. Lot No. _____ Recorded Plat _____

5. Private Claims _____

Register of Deeds Stamp & File Num

I, James L. Schwandt, in a field survey on 10-13, 1997 do hereby certify that under requirements of P.A. 74, Michigan P.A. of 1970, the corner points mentioned in lines 1 and 2 above were in conformance with regulations and rules therefore as required in the current manual of survey instructions of the United States Department of the Interior, Bureau of Land Management or by a decree of a Court of Law and /or that the corner points mentioned in lines 3, 4 and 5 above were in conformance with the rules of the Michigan Board of Land Surveyors or by a Decree of a Court of Law; established, re-established, monumented, re-monumented, recovered, found as expressed below:

	A	B	C	D	E	F	G	H	I	J	K	L
1												
2	6			5			4		3		2	1
3												
4	7						8		9		10	11
5												
6	18			17			16		15		14	13
7												
8	19			20			21		22		23	24
9												
10	30			29			28		27		26	25
11												
12	31			32			33		34		35	36
13												

A. Description of original monument and accessories and/or subsequent restoration:

I-13 T28N-R4W
G.L.O. W. Warner, 1856
Set Post
18" Hemlock N35°W, 12 Links
12" Hemlock N36°E, 11 Links

A. E. Newman, 1903
Sunk T RR Iron 2' Long for Cor
G. D. Henning, 1977
1/2" Bar
10" Poplar S35°E, 98.4'
12" Maple N29°E, 89.4'
6" Maple N41°W, 68.9'

N.F. Parker, 1982
1/2" Bar
8" Poplar S35°E, 98.4'
8" Maple N29°E, 89.4'
8" Maple N41°W, 68.9'

A.E. Newman, 1901
10" Tamarack S60°W, 30 Links
11" Cedar S21°E, 13 Links

B. Description of corner evidence found and/or method applied in restoring or reestablishing corner:

Fnd. Bent 1/2" Bar
Fnd. Nail 12" Maple N29°E, 89.45'
Fnd. Nail 12" Maple N41°W, 69.00' Overgrown & Badly Bent


CRAWFORD COUNTY
PEER GROUP APPROVAL
DATE OCT 16, 1997

Marvin E. Myers
Marvin E. Myers, P.S.
County Surveyor

C. Description of monument for corner and accessories established to perpetuate locating the position of the corner:

Replaced 1/2" bar with C.C.M.
C.C.M. is accepted as a careful and faithful perpetuation of the position of the original corner.

Set Spk. PP N65°W, 95.60'
Set Spk. PP S70°W, 105.47'
Set Spk. 10" Twin Aspen S40°E, 74.55'
Fnd. Nail 12" Maple N29°E, 89.45'
Fnd. Nail 12" Maple N41°W, 69.00'

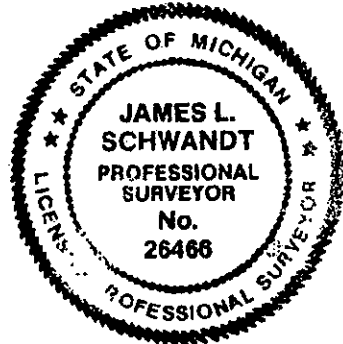

Signed by James L. Schwandt
Surveyor's Michigan License No. _____
26466

Date 12-15-97