

LAND CORNER RECORDATION CERTIFICATE

FILING REQUIREMENT OF ACT 74, MICH. P.A.1970

FOR CORNERS OF--:	LOCATED IN--:	CORNER CODE NUMBER
1. PUBLIC LAND SURVEY _____	T. 27 N. R. 4 W.	B-6, <u>B-7</u>
2. PROPERTY CONTROLLING IN SECTION 18 _____	T. 27 N. R. 4 W.	14; 16
3. MISCELLANEOUS PROPERTY IN SECTION _____	T. _____ N. S. R. _____ E. W.	_____
4. LOT NO. _____, RECORDED PLAT _____		
5. PRIVATE CLAIMS _____		

REGISTER OF DEEDS STAMP AND FILING NUMBER

I, Kenneth J. Ostling, do hereby certify that under requirements of P.A. 74, Michigan P.A. of 1970, the corner points mentioned in lines 1 and 2 above were, in a field survey on March 7, 1979, 19____, established, re-established, monumented, re-monumented, recovered or restored as expressed below and in conformance with regulations and rules therefore as required in the current manual of survey instructions of the United States Department of the Interior, Bureau of Land Management or by a decree of a court of law. Furthermore, that the corner points mentioned in lines 3, 4 and 5 above were, in a field survey on _____, 19____, found, recovered, restored, established or re-established as expressed below and in conformance with the rules of the Michigan State Board of Registration for Land Surveyors or, by a Decree of a Court of law:

~~*A. - Description of original monument and accessories and/or subsequent restorations~~

C. (continued)

16
 Fd. 5/8" Rerod in Place
 9" Tamarack S05°W 29.26
 8" Tamarack S41°E 11.83
 Set Cedar Post

B. Description of corner evidence found and/or method applied in restoring or re-establishing corner:


- B-6 Set corner at the calculated intersection of the true 1/4 lines, per standard survey procedure for the subdivision of sections.
- B-7 Corner established in 1957 survey of Sec. 19, by proportionate measurement. Rewitnessed for proper recording.
- 14 Set corner by standard survey procedure for the subdivision of sections.
- 16 Found iron in place at proper location for corner; origin unknown.

C. Description of monument for corner and accessories established to perpetuate locating the position of the corner:

B-6	B-7	14
Set 5/8" Rod w/RLS Cap and Cedar Post	Fd. DNR Monument & Cedar Post	Set 5/8" Rod w/RLS Cap and Cedar Post
10" Cedar N69°E 36.18	10" J. Pine N42°E 25.27	3" Cedar S26°E 31.65
8" Cedar N23°E 31.97	*10" J. Pine N89°E 8.85	6" Cedar S88°E 8.64
	*1957 Witness	

SIGNED BY Kenneth J. Ostling DATE 5-16-79

SURVEYOR'S MICHIGAN REGISTRATION NO. 10068

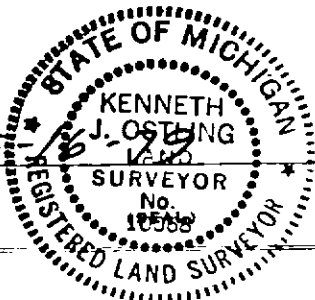

FOR STATE AND UNITED STATES AGENCIES:

SIGNED BY _____ DATE _____
CHIEF OF SURVEY PARTY

APPROVED AND SIGNED BY _____ DATE _____
MICHIGAN REGISTERED LAND SURVEYOR

SURVEYOR'S MICHIGAN REGISTRATION NO. _____ CRAWFORD COUNTY

MAY PLACE SKETCH ON BACK OR ATTACHED SHEET