

LAND CORNER RECORDATION CERTIFICATE
Filing Requirement of Act 74, Mich. P.A. 1970

For corners in
Crawford
(County)

Located In:

Corner Code H-3

- | | | | | | | |
|------------------------------------|---|------------|---|-----------|------------|-------|
| 1. Public Land Survey | T | <u>27N</u> | R | <u>4W</u> | <u>H-3</u> | |
| | T | _____ | R | _____ | _____ | |
| | T | _____ | R | _____ | _____ | |
| | T | _____ | R | _____ | _____ | |
| 2. Property Controlling in Section | S | _____ | T | _____ | R | _____ |
| | S | _____ | T | _____ | R | _____ |
| 3. Miscellaneous Property in Sec. | S | _____ | T | _____ | R | _____ |
| | S | _____ | T | _____ | R | _____ |

Register of Deeds Stamp & File Number

4. Lot No. _____, Recorded Plat _____
 5. Private Claims _____

I, Carl R. Johnson, in a field survey on May 22, 1991, 19_____, do hereby certify that under requirements of P.A. 74, Michigan P.A. of 1970, the corner points mentioned in lines 1 and 2 above were in conformance with regulations and rules therefore as required in the current manual of survey instructions of the United States Department of the Interior, Bureau of Land Management or by a decree of a Court of Law and/or that the corner points mentioned in lines 3, 4 and 5 above were in conformance with the rules of the Michigan Board of Land Surveyors or by a Decree of a Court of Law; established, re-established, monumented, re-monumented, recovered, found as expressed below:

NOTE: Not more than 4 corners, all in the same town and range, may be recorded on this certificate.

	A	B	C	D	E	F	G	H	I	J	K	L	M
2	6	5	4	3	2	1							
3								●					
4	7	8	9	10	11	12							
5													
6	18	17	16	15	14	13							
7													
8	19	20	21	22	23	24							
9													
10	30	29	28	27	26	25							
11													
12	31	32	33	34	35	36							
13													


A. Description of original monument and accessories and/or subsequent restoration:

B. Description of corner evidence found and/or method applied in restoring or reestablishing corner:

H-3
 3/4" pipe as shown on previous survey drawing, was pulled out and lying down.
 Replaced corner by previous survey data measurements.

C. Description of monument for corner and accessories established to perpetuate locating the position of the corner:

H-3
 1/4 cor. common to sec. 3 & 10
 DNR mon. and cedar post
 Cedar post 4" North 10.0'
 Maple 40" S 25 E 39.9'
 Maple 10" S 32 N 64.0'
 Maple 24" N 04 E 30.8'
 Maple 24" N 47 E 44.7'

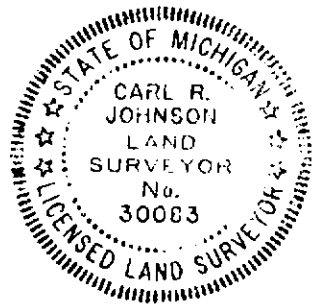

Signed by Carl R. Johnson
 Surveyor's Michigan License No. 30083

Date 1-6-92