

LAND CORNER RECORDATION CERTIFICATE

Filing Requirement of Act 74, Mich. PA 1970


For Corners In: <u>Crawford</u> (County)	Located In	Corner Code #
1. Public Land Survey	T <u>27N</u> R <u>4W</u>	<u>C12</u>
	T _____ R _____	_____
2. Property Controlling in Section	S _____ T _____ R _____	_____
	S _____ T _____ R _____	_____
3. Miscellaneous Property in Section	S _____ T _____ R _____	_____
	S _____ T _____ R _____	_____

Register of Deeds Stamp & File Number

4. Lot No: _____ Recorded Plat: _____

5. Private Claims: _____

I, Craig W. McVean, in a field survey on September 20, 2000 do hereby state that under requirements of PA 74, Michigan PA of 1970, the corner points mentioned in lines 1 and 2 above were in conformance with regulations and rules therefore as required in the current manual of survey instructions of the United States Department of the Interior, Bureau of Land Management or by a decree of a Court of Law and/or that the corner points mentioned in lines 3, 4 and 5 above were in conformance with the rules of the Michigan Board of Land Surveyors or by a Decree of a Court of Law; established, re-established, monumented, recovered, found as expressed below:

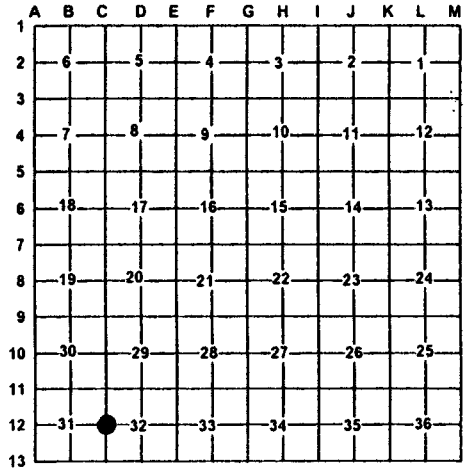

NOTE: Not more than 2 corners, all in the same town and range, may be recorded on this certificate.

A. Description of original monument and accessories and/or subsequent restoration:

- C12 – GLO Resurvey – Old ¼ Sec. corner – A.P. Brewer – 1852
- (O) S. Pine 8" S85°W 20 L.
 - (O) S. Pine 6" S71°E 13 L.
 - 1955 – K.J. Ostling – set post by single proportion and 17 links East of straight line between C11 & C13 (to agree w/ GLO Dependent Resurvey).
 - Rec. Sur. L. 170, P.33 – C.E. Ostling – 1976 – ½" Bar; 9" J.P. N. 40.8' 6" Tw. J.P. WSW 25.0
 - Rec. Sur. L. 171, P. 84 – G.D. Henning – 1978 – ½" Bar 9" J. Pine North 40.8' 6" Tw. J. Pine WSW 25.0'
 - Rec. Sur. – L.185, P.403-404 – N. Parker – 1980 – Same as Henning

B. Description of corner evidence found and/or method applies in restoring or re-establishing corner:

C12 – ¼ corner common to Sec. 31 & 32 – Fd. ½" x 18" Rebar & rotten Cedar post bottom along side in agreement with K.J. Ostling's survey. Measured N10°W 40.8' to Blaze on dead 9" J. Pine per C.E. Ostling. ½" Rebar accepted as a careful & faithful re-establishment of the position of the original corner.

C. Description of monument for corner and accessories established to perpetuate locating the position of the corner:

C12 – Replaced ½" x 18" Rebar & rotten post bottom with 4" DOC (DNR) Alum. Cap on 1" x 36" Galv. Iron pipe w/ ring of broken concrete.

Set Blue Carsonite Post 1' N.

S70°E 21.36' to N & T in N side 7" J. Pine scribed 'XBT'

S63°W 12.74' to N & T in N side 5" J. Pine scribed 'XBT'

S7°W 19.66' to N & T in E side 4" J. Pine

N2°E 37.17' to N & T in W side 5" J. Pine



Signed by: Craig W. McVean

Surveyor's Michigan License No.: 39088

Date: 4/11/2001