


LAND CORNER RECORDATION CERTIFICATE

Filing Requirement of Act 74, Mich. PA 1970

For Corners In: Crawford (County)	Located In	Corner Code #
1. Public Land Survey	T _____ R _____	_____
	T _____ R _____	_____
2. Property Controlling in Section	S 31 T 27N R 4W	6
	S 31 T 27N R 4W	7
3. Miscellaneous Property in Section	S _____ T _____ R _____	_____
	S _____ T _____ R _____	_____

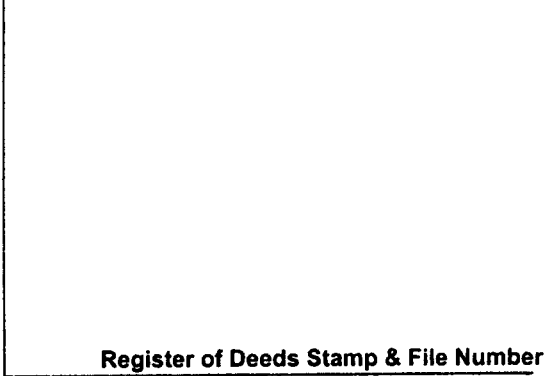


4. Lot No: _____ Recorded Plat: _____

5. Private Claims: _____

I, Craig W. McVean, in a field survey on September 20, 2000 do hereby state that under requirements of PA 74, Michigan PA of 1970, the corner points mentioned in lines 1 and 2 above were in conformance with regulations and rules therefore as required in the current manual of survey instructions of the United States Department of the Interior, Bureau of Land Management or by a decree of a Court of Law and/or that the corner points mentioned in lines 3, 4 and 5 above were in conformance with the rules of the Michigan Board of Land Surveyors or by a Decree of a Court of Law; established, re-established, monumented, recovered, found as expressed below:

NOTE: Not more than 2 corners, all in the same town and range, may be recorded on this certificate.

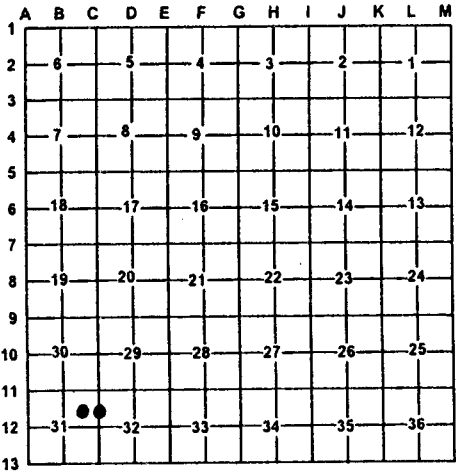

- A. Description of original monument and accessories and/or subsequent restoration:**
- 6 - Rec. Sur. - L.170, P.33 - C.E. Ostling - 1976
 1/2" x 18" Bar
 - Rec. Sur. - L.171, P.83 & 84 - G.D. Henning - 1978 -
 Set 1/2" Bar
 12" Oak NE 9.75'; 10" J. Pine SE 24.3'; 5" J. Pine NW 39.35'
 - 7 - K.J. Ostling - 1955 - Corner tile 9 1/2 L. West of line
 - Rec. Sur. - L.170, P.29 & 33 - C.E. Ostling - 1976
 Conc. tile Mon.; 10" J. Pine E. 31.0
 10" J. Pine N25.5'
 - Rec. Sur. - L.171, P.83 & 84 - Fd. conc. tile- same wit.
 as C.E. Ostling.

- B. Description of corner evidence found and/or method applies in restoring or re-establishing corner:**
- 6 - NE 1/16 cor. Sec. 31 - Fd. 1/2" CIR #2240 per L. 171, P.83.
 Fits Ostling's survey. Fits calculated position closely.
 CL of N-S Sand Rd. is 12' W. 1/2" CIR accepted as the best
 available evidence of the position of the corner.
 - 7 - N 1/16 cor. common to Sec. 31 & 32 - Fd. 4" Conc. Vit. Tile
 Mon. w/ sq. bolt per Rec. Surveys. Tile fits calculated position
 very close. K. Ostling notes that the corner tile was 9 1/2 L.
 West of line in 1955 so it probably was adjusted since then, I
 can only surmise. Conc. Tile Mon. accepted as the best
 available evidence of the position of the corner.

- C. Description of monument for corner and accessories established to perpetuate locating the position of the corner:**
- 6 - Replaced 1/2" CIR #2240 w/ 2" Alum. Cap on 5/8" x 34" Rebar.
 Set Blue Carsonite Post w Loc. tag 1' SE
 N25°E 10.03' to set N & T in W side 16" B. Oak (GH)
 S44°E 22.02' to set N & T in NE side 8" J. Pine
 South 14.95' to set N & T in E side 8" J. Pine
 N61°W 39.42' to set N & T in N. side 8" J.Pine (GH)
 - 7 - 4" Conc. Tile Mon. w/ sq. bolt
 Set Blue Carsonite Post w/ Loc. tag 1' SE
 N78°E 30.58' to set N & T in N side 15" J. Pine (CEO, GH)
 N53°W 30.96' to set N & T in NE side 6" J. Pine
 S22°E 26.98' to set N & T in W side 3" J. Pine
 S87°W 27.94' to set N & T in S side 4" J. Pine
 NW 0.5' to face Fd. wood post

Signed by: Craig W. McVean
 Surveyor's Michigan License No.: 39088

Date: 4/11/2001

