

MAR 29 2000

LAND CORNER RECORDATION CERTIFICATE
Filing Requirement of Act 74, Mich. P.A. 1970

For corners in SECTION

STATE OF MICHIGAN
CRAWFORD COUNTY
RECORDED

22 FEB 2000 12:45 PM

SANDRA MOORE
REGISTER OF DEEDS

<u>Crawford</u> (County)	Located In:	Corner Code #
1. Public Land Survey	T <u>28N</u> R <u>1W</u>	<u>D-1</u>
	T _____ R _____	_____
	T _____ R _____	_____
	T _____ R _____	_____
2. Property Controlling in Section	S _____ T _____ R _____	_____
	S _____ T _____ R _____	_____
3. Miscellaneous Property in Sec.	S _____ T _____ R _____	_____
	S _____ T _____ R _____	_____

Register of Deeds Stamp & File Number

4. Lot No. _____, Recorded Plat _____
5. Private Claims _____

LIBER 4 PAGE 85

I, Ronald C. Brand, in a field survey on October 14, 1999 do hereby state that under requirements of P.A. 74, Michigan P.A. of 1970, the corner points mentioned in lines 1 and 2 above were in conformance with regulations and rules therefore as required in the current manual of survey instructions of the United States Department of the Interior, Bureau of Land Management or by a decree of a Court of Law and/or that the corner points mentioned in lines 3, 4 and 5 above were in conformance with the rules of the Michigan Board of Land Surveyors or by a Decree of a Court of Law; established, re-established, monumented, recovered, found as expressed below:

1	A	B	C	D	E	F	G	H	I	J	K	L	M
2	6			5		4		3		2		1	
3													
4	7			8		9		10		11		12	
5													
6	15			17		16		15		14		13	
7													
8	19			20		21		22		23		24	
9													
10	30			29		28		27		26		25	
11													
12	31			32		33		34		35		36	
13													

NOTE: Not more than 2 corners, all in the same town and range, may be recorded on this certificate.

A. Description of original monument and accessories and/or subsequent restoration:
D-1 North One-Quarter Corner Section 5

1839 James Mullett Pine 3" at 1/4 Post

1856 Resurvey Harvey Mellon Set 1/4 Section Post at 40.00 Spr. Pine 3" N18°W 33 links, Spr. Pine 4" N26°E 28 links

1923 E.S. Houghton Set 4" Clay Tile Monument at quarter section corner. No accessories given. See Crawford County Surveyors Record and Field Book

1968 DNR Retracement, Kenneth Ostling, set standard Conservation Department Monument by single proportionate measure J. Pine 6" N13°W 81.2', B. Oak 12" S44°E 64.1'

1968 S.O. Thorsen County Surveyor notes, Liber 3, Page 489 J. Pine 6" N13°W 81.2', B. Oak 12" S44°E, 64.1'

B. Description of corner evidence found and/or method applied in restoring or reestablishing corner:

D-1 North One-Quarter Corner Section 5

Fd. Standard DNR Monument 57' South of centerline trail road. Fd. J. Pine 12" N14°W 81.46', Fd. B. Oak 18" S43°E 64.49'

Fd. 4" diameter Clay Tile Monument from Houghton with 5/8" rod 6" above ground 67.8' North and 23.6' East of DNR Monument Clay Tile Monument is 10' North of centerline trail road. The method used in establishing the position for this monument is unknown. No accessories to its position were given by Houghton and therefore absolute verification of its position is difficult.

The Monument placed by the DNR in 1968 results in a more equitable distribution of lands among the sections to the North and South. The peer review groups, after much deliberation, in both Crawford and Otsego Counties felt the position established by the DNR should be accepted for these reasons.

C. Description of monument for corner and accessories established to perpetuate locating the position of the corner:

D-1 North One-Quarter Corner Section 5

Fd. Standard DNR monument is accepted as a careful and faithful reestablishment of the position of the original corner. Monument is 57' South of trail road. Set Nail & Tag in blazed 12" J. Pine N14°W 81.46' Set Nail & Tag 18" B. Oak S43°E 64.49'

Set Nail & Tag 5" J. Pine S62°W 35.93' Set Nail & Tag 9" Poplar N50°W 9.63' 4" Clay Tile Mon. N19°E 71.78'


CRAWFORD COUNTY

Signed by PEER GROUP APPROVAL

Surveyor DATE Dec 14, 1999

Marvin E. Myers

Marvin E. Myers, P.S.
County Surveyor

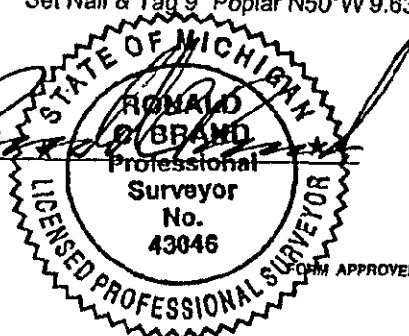

Date

12/22/99