

MAR 22 1999

LIBER

3 PAGE

339

SECTION

LAND CORNER RECORDATION CERTIFICATE
Filing Requirement of Act 74, Mich. P.A. 1970

For corners in

Crawford (County)	Located In:	Corner Code #
1. Public Land Survey	T <u>28NR 1W</u>	<u>D-9</u>
	T _____ R _____	_____
	T _____ R _____	_____
	T _____ R _____	_____
2. Property Controlling in Section	S _____ T _____ R _____	_____
	S _____ T _____ R _____	_____
3. Miscellaneous Property in Sec.	S _____ T _____ R _____	_____
	S _____ T _____ R _____	_____

STATE OF MICHIGAN
CRAWFORD COUNTY
RECORDED


29 DEC 98 9:48 A.M.

SARAH MOORE
REGISTER OF DEEDS

Register of Deeds Stamp & File
Number

4. Lot No. _____, Recorded Plat _____
5. Private Claims _____

I, Marvin E. Myers, in a field survey on Nov 27, 19 98 do hereby state that under requirements of P.A. 74, Michigan P.A. of 1970, the corner points mentioned in lines 1 and 2 above were in conformance with regulations and rules therefore as required in the current manual of survey instructions of the United States Department of the Interior, Bureau of Land Management or by a decree of a Court of Law and /or that the corner points mentioned in lines 3, 4 and 5 above were in conformance with the rules of the Michigan Board of Land Surveyors or by a Decree of a Court of Law; established, re-established, monumented, recovered, found as expressed below:

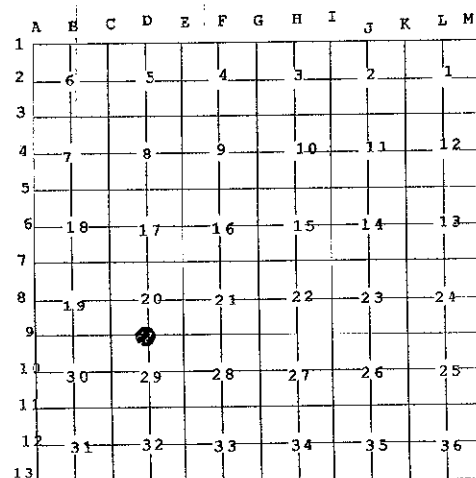

NOTE: Not more than 2 corners, all in the same town and range, may be recorded on this certificate.

A. Description of original monument and accessories and/or subsequent restoration:

G.L.O. 1858 W. Warner, DS	May 12, 1964 S. Thorsen, P.S. #5788
Mon: Post	Mon - Not given
Wit: 9" S. Pine S78°W 34 links	Wit: None given
10" S. Pine N54 1/2°W 36 links	
Old Map (Purported to be Houghton)	Farnham, Wirries, & Berning

1996 R.F. Mitchell, P.S. #28417
Mon - Fd. Conc. Mon. recorded L. 1, P. 25

(Late 1800's to Early 1900's)	Date unknown
Mon - not given (Clay Tile Mon Typ.)	Mon - Not Given
Wit: None Given	

Sept 25, 1996 R.F. Mitchell, P.S. #28417
Mon - Fd. Conc.. Mon. recorded L. 1, P. 25

June 15, 1962	C.E. Ostling No Date
G.D. Henning, P.S. #2240	Mon - Not given
Mon - Found material not given	LCRC L. 1, P. 25 Aug 11, 1971
Wit: None given	C.E. Ostling, P.S. # 12026
	Mon - Fd. Monument
	Wit: 14" J. Pine N89°E 21.0 (Henning)
	14" J. Pine S44°W 87.9 (Henning)
	Oct. 1990 M.E. Myers, P.S. 31600
	Mon - Fd. Clay Tile Mon.
	of record.

**CRAWFORD COUNTY
PEER GROUP APPROVAL
DATE DEC 4, 1998**

Marvin E. Myers
**Marvin E. Myers, P.S.
County Surveyor**

B. Description of corner evidence found and/or method applied in restoring or reestablishing corner:
Found Concrete Clay Tile Monument; found 14" J. Pine N89°E 21.0 (Henning); found 14" J. Pine S44°W 87.9 (Henning); found 10" J. Pine S78°E 21.2; found spike in East side 6" J. Pine S22°E 15.8; found 1 1/4" Pipe South 0.5; found 12" J. Pine S50°W 76.42; found G.D. Henning nail and tag 10" J. Pine N80°W 96.85 Accepted Concrete Clay Tile Monument as the best available evidence of the position of the Original Corner, left monument in place in excellent condition.

C. Description of monument for corner and accessories established to perpetuate locating the position of the corner:
Mon - Left Clay tile filled with concrete with iron inside in place. Existing monument is in excellent condition.
Wit: Found spike in North side 14" J. Pine N89°E 21.0
Found spike in NE side 12" J. Pine S22°E 15.35
Found spike in North side 10" Norway N60°W 10.36
Set Carsonite Post 2.0' ± North.

Signed by _____
Surveyor's Michigan License No. 31600

Date December 23, 1998

