

DEC 22 1998

SECTION

LAND CORNER RECORDATION CERTIFICATE
Filing Requirement of Act 74, Mich. P.A. 1970

STATE OF MICHIGAN
CRAWFORD COUNTY
RECORDED

29 DEC 98 9:48 A.M.

SANDRA MOORE
REGISTER OF DEEDS

Register of Deeds Stamp & File Number

For corners in

Form with fields for Crawford (County), Located In: T 28N R 1W, Corner Code # E-11, and sections 1-5 for Public Land Survey, Property Controlling, Miscellaneous, Lot No., and Private Claims.

Grid table with columns A-M and rows 1-13. A black dot is located at the intersection of column G and row 10.

I, Marvin E. Myers, in a field survey on Dec 2, 1998 do hereby state that under requirements of P.A. 74, Michigan P.A. of 1970, the corner points mentioned in lines 1 and 2 above were in conformance with regulations and rules therefore as required in the current manual of survey instructions of the United States Department of the Interior, Bureau of Land Management or by a decree of a Court of Law and for that the corner points mentioned in lines 3, 4 and 5 above were in conformance with the rules of the Michigan Board of Land Surveyors or by a Decree of a Court of Law; established, re-established, monumented, recovered, found as expressed below:

NOTE: Not more than 2 corners, all in the same town and range, may be recorded on this certificate.


- A. Description of original monument and accessories and/or subsequent restoration:
GLO - 1858 W. Warner, D.S. Mon - Post
Wit: 6" S. Pine S34°E 31 Links
7" S. Pine N78°W 31 Links
L163, P. 110 Sept 1977 N. Parker, PS
Mon - 1/2" Pipe
Wit: Face of P. Pole S76°W 56.2
Fence Cor. Post S85°E 9.35
10" J. Pine N38°E 52.1
Cen. of Lovells Rd is 24± West
Farnham, Wirries, & Berning
Mon - not given
Wit: none given
LCRC L. 2, P. 151 Sept 1977
N. Parker # 16939
Mon - Fd. 1/2" Pipe used in previous surveys of record
Wit: Face of P. Pole S76°W 56.2
10" J. Pine N38°E 52.1
Cen. of Lovells Rd is 23.75 West
L. 247 P. 45 May 28, 1986 F. J. King #25852
Mon - Fd. 1/2" Pipe
Wit: Center of Road West 32.6± in line with E-W fence
L. 463, P. 423 Aug 14, 1998 R. Brand #43046
Mon - Fd. Bar & Cap as rec. in L2, P151
Wit: 33.1 West to Center line of road
Fd. Nail 6" J. Pine S34°E 26.88
Fd. Nail 8" J. Pine N53°E 26.60
Set Pk nail in P. Pole S31°W 132.60
Set Pk nail in P. Pole N31°W 128.80
(Note the above witnesses are for E-10)

B. Description of corner evidence found and/or method applied in restoring or reestablishing corner:
Found 1/2" bar & cap #25852 over a bent 1/2"x36" pipe 24± East of Lovells Road in line with E-W Fence; Found Fence Corner post S85°E 9.35 Face of Power Pole (stub) S72°W 56.2; 10" J. Pine N38°E 52.1; found spike in 10" J. Pine S51°E 58.65; found spike in 12" J. Pine N88°E 119.55; found spike in 5" J. Pine N80°W 84.64 Accepted as the best available evidence of the position of the Original Corner.

C. Description of monument for corner and accessories established to perpetuate locating the position of the corner:
Mon - Standard Crawford County Monument in Monument Box over 1/2"x36" pipe
Wit: Face of P. Pole Stub S76°W 56.2
Found spike 10" J. Pine S51°E 57.51
Found spike 12" J. Pine N88°E 119.55
Found spike 5" J. Pine N80°W 84.58
Nail & tag S. side P. Pole S75°W 58.33
Set carsonite Post S51°E 6.7±
Found BM # R-9 S80°W 49.84

CRAWFORD COUNTY
PEER GROUP APPROVAL
DATE Dec 4, 1998

Marvin E. Myers, P.S.
County Surveyor

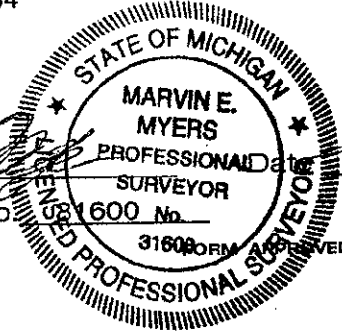

Signed by [Signature]
Surveyor's Michigan License No. 081600

DEC 23, 1998