

MAR 29 2000

SECTION

LAND CORNER RECORDATION CERTIFICATE
Filing Requirement of Act 74, Mich. P.A. 1970
Also Act 345, PA 1990

For corners in

<u>Crawford</u> (County)	Located In:	Corner Code #
1. Public Land Survey	T <u>28N</u> R <u>1W</u>	<u>J-13</u>
	T <u>27N</u> R <u>1W</u>	<u>J-T</u>
	T _____ R _____	_____
	T _____ R _____	_____
2. Property Controlling in Section	S _____ T _____ R _____	_____
	S _____ T _____ R _____	_____
3. Miscellaneous Property in Sec.	S _____ T _____ R _____	_____
	S _____ T _____ R _____	_____
4. Lot No. _____, Recorded Plat _____		
5. Private Claims _____		

STATE OF MICHIGAN
CRAWFORD COUNTY
RECORDED
28 DEC 99 3:01 P.M.
SANDRA MOORE
REGISTER OF DEEDS

Register of Deeds Stamp & File Number

LIBER 4 PAGE 68

I, James L. Schwandt, in a field survey on May 14, 19 99, do hereby state that under requirements of P.A. 74, Michigan P.A. of 1970, the corner points mentioned in lines 1 and 2 above were in conformance with regulations and rules therefore as required in the current manual of survey instructions of the United States Department of the Interior, Bureau of Land Management or by a decree of a Court of Law and/or that the corner points mentioned in lines 3, 4 and 5 above were in conformance with the rules of the Michigan Board of Land Surveyors or by a Decree of a Court of Law; established, re-established, monumented, recovered, found as expressed below:

A	B	C	D	E	F	G	H	I	J	K	L	M
1												
2	6	5	4	3	2	1						
3												
4	7	8	9	10	11	12						
5												
6	18	17	16	15	14	13						
7												
8	19	20	21	22	23	24						
9												
10	30	29	28	27	26	25						
11												
12	31	32	33	34	35	36						
13												

NOTE: Not more than 4 corners, all in the same town and range, may be recorded on this certificate.

A. Description of original monument and accessories and/or subsequent restoration:

- 1.) Post set by James Mullett D.S., 1839, 40 chains from SE corner of Section 35 Remeasured by Walter Warner in 1858 as 39,000 chains
- 2.) Carlos Laguire (date unknown)
Found a 1/4 post


B. Description of corner evidence found and/or method applied in restoring or reestablishing corner:

Found 1 1/2" pipe in broken concrete in centerline road
 Found blaze and spike 16" Pine, N58°W, 54.39'
 Found blaze and spike 8" Pine, N40°E, 43.85'
 Found blaze and spike 6" Cherry, S51°W, 59.05'

CRAWFORD COUNTY
PEER GROUP APPROVAL
DATE Jan 7, 1999
Marvin E. Myers
Marvin E. Myers, P.S.
County Surveyor

C. Description of monument for corner and accessories established to perpetuate locating the position of the corner:

Replaced 1 1/2" pipe in broken concrete in centerline road with Crawford County Monument and is accepted as a careful and faithful reestablishment of the position of the original corner.
 Spike 16" Pine, N58°W, 54.39'
 Spike 8" Pine, N40°E, 43.85'
 Spike 6" Oak, S51°W, 59.05'
 Spike 6" Pine, S23°W, 47.62'

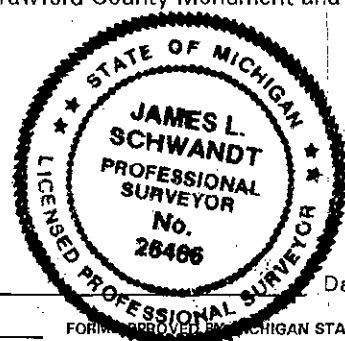

Signed by James L. Schwandt
 Surveyor's Michigan License No. 26466

Date 12-10-99