

7/2

CRAWFORD COUNTY REMONUMENTATION
LIBER 3 PAGE 110
LAND CORNER RECORDATION CERTIFICATE
Filing Requirement of Act 74, Mich. P.A. 1970

STATE OF MICHIGAN
COUNTY OF CRAWFORD

For corners in

Crawford

(County)

Located In:

Corner Code #

- | | | | | | |
|------------------------------------|---|-----|---|----|-----|
| 1. Public Land Survey | T | 28N | R | 1W | M-3 |
| | T | | R | | |
| | T | | R | | |
| | T | | R | | |
| 2. Property Controlling in Section | S | | T | R | |
| | S | | T | R | |
| 3. Miscellaneous | S | | T | R | |
| Property in Sec. | S | | T | R | |

FILED FOR RECORD THIS
6th DAY OF Dec, 1993
3:20 am/pm IN LIBER 34
PAGE 110

Elizabeth A. Wilson

Register of Deeds

Register of Deeds Stamp & File Number

4. Lot No. _____, Recorded Plat _____
5. Private Claims _____

	A	B	C	D	E	F	G	H	I	J	K	L	M
2	6	5	4	3	2	1							
3													
4	7	8	9	10	11	12							
5													
6	18	17	16	15	14	13							
7													
8	19	20	21	22	23	24							
9													
10	30	29	28	27	26	25							
11													
12	31	32	33	34	35	36							
13													

I, Marvin E. Myers, in a field survey on OCT 10, 19 93, do hereby certify that under requirements of P.A. 74, Michigan P.A. of 1970, the corner points mentioned in lines 1 and 2 above were in conformance with regulations and rules therefore as required in the current manual of survey instructions of the United States Department of the Interior, Bureau of Land Management or by a decree of a Court of Law and/or that the corner points mentioned in lines 3, 4 and 5 above were in conformance with the rules of the Michigan Board of Land Surveyors or by a Decree of a Court of Law; established, re-established, monumented, re-monumented, recovered, found as expressed below:

NOTE: Not more than 4 corners, all in the same town and range, may be recorded on this certificate.

A. Description of original monument and accessories and/or subsequent restoration:

GLO - May 1839 Hodgeson & Sibley	DNR May 1953
Mon. - Post	Fd. stake checked GLO ties to stream South & swamp West
WIT: 8" Pine N28°W 19 lks.	WIT: 10" Aspen S35°W 48 lks.
9" Aspen S62°W 19 lks.	Walker Feb. 1992


Consumers Power Co. Oct. 1967
Mon. - Fd. DNR Monument
WIT: Nail & Blaze 6" Maple S. 17.10'
Nail & Blaze 3" Maple W. 3.45'
Nail & Blaze 4" Cherry E. 13.56'

B. Description of corner evidence found and/or method applied in restoring or reestablishing corner:

M-3 Found 1" Pipe with brass cap verified location by measurement to accessories and corners of record.

C. Description of monument for corner and accessories established to perpetuate locating the position of the corner:

M-3 Mon. - Dept. of Conservation Mon. left in place
WIT: Fd. nail and blaze in 6" (now 17") Maple S25°W 17.00'
Fd. nail and blaze in 3" (now 7") Maple S70°W 3.45'
Fd. nail and blaze in 4" (now 8") B. Cherry S77°E 13.56' (R) 13.70' (M)
nail & tag 6" Poplar N35°E 12.70'
nail & tag 8" Poplar S55°E 18.00'
nail & tag 9" Poplar S24°E 23.64'
nail & tag 7" Poplar N78°W 17.37'

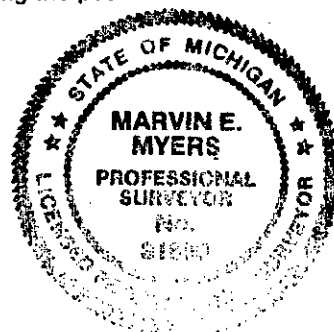

Signed by Marvin E. Myers

Date Dec 4, 1993

Surveyor's Michigan License No. 31600

DATE NOV 29, 1993

PEER GROUP APPROVAL