

LAND CORNER RECORDATION CERTIFICATE
Filing Requirement of Act 74, Mich. P.A. 1970

STATE OF MICHIGAN
COUNTY OF CRAWFORD

For corners in

Table with columns: Crawford (County), Located In:, Corner Code #. Includes entries for Public Land Survey, Property Controlling in Section, and Miscellaneous Property in Sec.

FILED FOR RECORD THIS
6th DAY OF Dec, 1993
3:20 am/pm IN LIBER 34c
PAGE 105
Register of Deeds
Register of Deeds Stamp & File Number

- 4. Lot No. , Recorded Plat
5. Private Claims

I, Marvin E. Myers, in a field survey on NOV 22, 1993, do hereby certify that under requirements of P.A. 74, Michigan P.A. of 1970, the corner points mentioned in lines 1 and 2 above were in conformance with regulations and rules therefore as required in the current manual of survey instructions of the United States Department of the Interior, Bureau of Land Management or by a decree of a Court of Law and/or that the corner points mentioned in lines 3, 4 and 5 above were in conformance with the rules of the Michigan Board of Land Surveyors or by a Decree of a Court of Law; established, re-established, monumented, re-monumented, recovered, found as expressed below.

Grid table with columns A-M and rows 2-13. Contains numbers 1-36 in a grid pattern.

NOTE: Not more than 4 corners, all in the same town and range, may be recorded on this certificate.

A. Description of original monument and accessories and/or subsequent restoration:


GLO - May 1839 Hodgeson & Sibley
Mon. - Post
WIT: 7" Birch N42°W 9 lks.
7" B.Oak S36°W 20 lks.

B. Description of corner evidence found and/or method applied in restoring or reestablishing corner:

Found pipe set in concrete base. This type of monument is typical of the type of monuments used by Marcus Schaaf (1911-1941) State of Michigan Forestry Dept. Surveyor. No record of Schaaf setting this corner was found. Telephone conversation with Carl Roser, P.S. DNR confirmed that the monument could be by Schaaf and that some of Schaaf records are gone. The monumented location was accepted as the best available evidence of the position of the corner replaced with standard Crawford County monument.

C. Description of monument for corner and accessories established to perpetuate locating the position of the corner:

Mon. - Set Std. 22" Crawford County mon.
WIT: nail & tag W. 14" J.Pine N21°E 31.76'
nail & tag N. 14" R.Pine N80°E 34.76'
nail & tag 18" TW.Oak S88°W 13.77'
nail & tag NE 8" Maple S35°E 11.79'

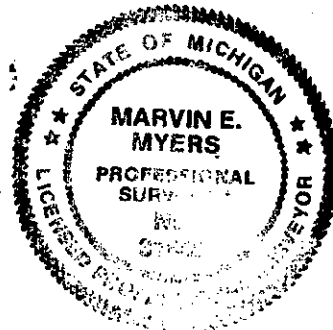

Signed by Marvin E. Myers Date DEC 4, 1993

Surveyor's Michigan License No. 31600

Date NOV 29, 1993

PEER GROUP APPROVAL