

LAND CORNER RECORDATION CERTIFICATE

FILING REQUIREMENT OF ACT 74, MICH. P.A.1970

FOR CORNERS OF--:	LOCATED IN--:	CORNER CODE NUMBER
1. PUBLIC LAND SURVEY. _____	T. 28 N. R. 1 E.	G-11; G-12; G-13
2. PROPERTY CONTROLLING IN SECTION 34 _____	T. 28 N. R. 1 E.	10
3. MISCELLANEOUS PROPERTY IN SECTION _____	T. _____ N. S. R. _____ E. W.	_____
4. LOT NO. _____, RECORDED PLAT _____		
5. PRIVATE CLAIMS _____		

REGISTER OF DEEDS STAMP AND FILING NUMBER _____

I, Kenneth J. Ostling do hereby certify that under requirements of P.A. 74, Michigan P.A. of 1970, the corner points mentioned in lines 1 and 2 above (identified with circles on index code diagram - over) were, in a field survey on July 22, 1974, established, re-established, monumented, re-monumented, recovered or restored as expressed below and in conformance with regulations and rules therefore as required in the current manual of survey instructions of the United States Department of the Interior, Bureau of Land Management or by a decree of a court of law. Furthermore, that the corner points mentioned in lines 3, 4 and 5 above were, in a field survey on 19__, found, recovered, restored, established or re-established as expressed below and in conformance with the rules of the Michigan State Board of Registration for Land Surveyors or, by a Decree of a Court of law:

A. Description of original monument and accessories and/or subsequent restoration:

B. Description of corner evidence found and/or method applied in restoring or re-establishing corner:

- G-11 Found RR spike in center of N-S blacktop, which was apparently used in other previous surveys.
- G-12 Set by proportionate measurement between section corners. No previous corner.
- G-13 Found 1 1/4" pipe apparently used by Hinning and others in previous surveys. Closing corner for Sections 3 and 4, T. 27 N., R. 1 E., is 26.7' west.
- 10 Set corner by standard survey procedure for the subdivision of sections.

C. Description of monument for corner and accessories established to perpetuate locating the position of the corner:

G-11	G-12	G-13
RR spike in center of blacktop road	DNR monument	1 1/4" pipe
6" J. Pine S60°E 61.4	11" Tamarack N30°E 7.4	*8" J. Pine N10°E 63.3
9" J. Pine S40°W 72.1	12" W. Pine N55°E 29.9	*J. Pine N58°W 106.3
*P. pole S45°E 46.8	12" Tamarack N77°W 20.5	*6" R. Pine Stp. N23°E 22.4
*Guy pole N53°E 45.0		*Henning NBT's
*Old NBT's		

10		
2 1/2' of 1 1/4" pipe		
12" J. Pine	S13°E	34.9
6" J. Pine	S83°E	31.3

SIGNED BY Kenneth J. Ostling DATE 11-1-74

SURVEYOR'S MICHIGAN REGISTRATION NO. 10068

FOR STATE AND UNITED STATES AGENCIES:


SIGNED BY _____ DATE _____

CHIEF OF SURVEY PARTY

APPROVED AND SIGNED BY _____ DATE _____

MICHIGAN REGISTERED LAND SURVEYOR

(SEAL)

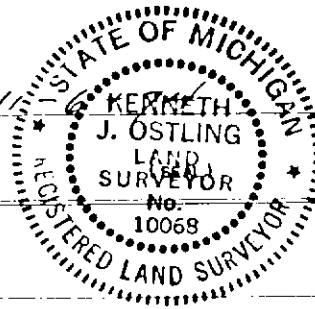

SURVEYOR'S MICHIGAN REGISTRATION NO. _____

OSCODA COUNTY