

LAND CORNER RECORDATION CERTIFICATE
Filing Requirement of Act 74, Mich. P.A. 1970

For corners in
CRAWFORD
 (County)

Located In: _____ Corner Code #/1 _____

- | | | | | | |
|------------------------------------|---|------------|---|-----------|------------|
| 1. Public Land Survey | T | <u>28N</u> | R | <u>1W</u> | <u>B-6</u> |
| | T | _____ | R | _____ | _____ |
| | T | _____ | R | _____ | _____ |
| | T | _____ | R | _____ | _____ |
| 2. Property Controlling in Section | S | _____ | T | _____ | R |
| | S | _____ | T | _____ | R |
| 3. Miscellaneous Property in Sec. | S | _____ | T | _____ | R |
| | S | _____ | T | _____ | R |

Register of Deeds Stamp & File Number

4. Lot No. _____, Recorded Plat _____
 5. Private Claims _____

I, C.F. ROSER, in a field survey on APRIL, 21, 19 95, do hereby certify that under requirements of P.A. 74, Michigan P.A. of 1970, the corner points mentioned in lines 1 and 2 above were in conformance with regulations and rules therefore as required in the current manual of survey instructions of the United States Department of the Interior, Bureau of Land Management or by a decree of a Court of Law and/or that the corner points mentioned in lines 3, 4 and 5 above were in conformance with the rules of the Michigan Board of Land Surveyors or by a Decree of a Court of Law, established, re-established, monumented, re-monumented, recovered, found as expressed below.

NOTE: Not more than 4 corners, all in the same town and range, may be recorded on this certificate.

	A	B	C	D	E	F	G	H	I	J	K	L	M
2	6	5	4	3	2	1							
3													
4	7	8	9	10	11	12							
5													
6	18	17	16	15	14	13							
7													
8	19	20	21	22	23	24							
9													
10	30	29	28	27	26	25							
11													
12	31	32	33	34	35	36							
13													

A. Description of original monument and accessories and/or subsequent restoration:
 B-6 B-6 CONT.


(NO EVIDENCE OF G.L.O. CORNER, B.T.'S, LINE TREES & TOPOGRAPHY, AS CALLED OUT IN THE G.L.O. LINE NOTES; UNLESS NOTED IN ITEM "B" BELOW.)

B. Description of corner evidence found and/or method applied in restoring or reestablishing corner:
 B-6 B-6 CONT.

FOUND AND ACCEPTED CONC. IN TILE FOR CENTER OF SEC. 18. THIS CENTER OF SEC. WAS ESTABLISHED BY COUNTY SURVEYOR E.S.HOUGHTON IN 1913 AND USED IN SUBSEQUENT SURVEYS; BY G.F.DELAMATER IN 1927 (ACCORDING TO HENNING), G.HENNING IN 1955, M.MYERS IN '88 AND OTHERS. A CONSERVATION DEPT. MON; S23°17'E, 31.37' AS SET BY G.SHADKO -CONT. RIGHT-
 IN 1948, BUT CAN NOT BE ACCEPTED, WAS REMOVED. SEE LETTERS BY DEPT. SURVEYORS K.J.OSTLING (DEC. 9,1975) AND C.F.ROSER (DEC. 1,1993) IN DEPT. SURVEY FILE FOR SHUPAC LAKE PAS #20-4 FOR ADDITIONAL INFO. ON OUR ACCEPTANCE OF E.S.HOUGHTON CORNER AS CENTER OF 5-18. FD. CONC. IN TILE IS IN POWER LINE R.O.W. AND IN LINE WITH FENCE E'LY.

C. Description of monument for corner and accessories established to perpetuate locating the position of the corner:
 B-6 B-6 CONT.

FD. CONC. IN TILE W/TWISTED SQUARE ROD.
 8" W.PINE S13°E 34.75'
 FACE END FENCE POST S79°E 7.44'
 12" R.PINE S82°E 44.54'
 5" MAPLE N42°E 28.70'
 SET 5/8" x 3/4" REROD W/PS CAP AT W. EDGE OF LAKE & ON 1/4 LINE S82°53'E 789.33'

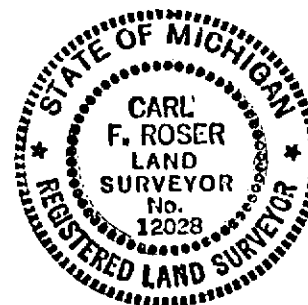

Signed by Carl F. Roser 12028 Date 4-21-95

Surveyor's Michigan License No. _____