

2/2/81

LAND CORNER RECORDATION CERTIFICATE

FILING REQUIREMENT OF ACT 74, MICH. P.A.1970

FOR CORNERS OF--:	LOCATED IN--:	CORNER CODE NUMBER
1. PUBLIC LAND SURVEY	T. 28 ^{N.} _{S.} , R. 1 ^{W.}	E-6; E-7
2. PROPERTY CONTROLLING IN SECTION	T. ^{N.} _{S.} , R. ^{E.} _{W.}	
3. MISCELLANEOUS PROPERTY IN SECTION	T. ^{N.} _{S.} , R. ^{E.} _{W.}	
4. DEED NO. _____, RECORDED PLAT		
5. PRIVATE CLAIMS		

REGISTER OF DEEDS STAMP AND FILING NUMBER

I, **KENNETH J. OSTLING**, do hereby certify that under requirements of P.A. 74, Michigan P.A. of 1970, the corner points mentioned in lines 1 and 2 above were, in a field survey on **SEPTEMBER 28**, 1981, established, re-established, monumented, re-monumented, recovered or restored as expressed below and in conformance with regulations and rules therefore as required in the current manual of survey instructions of the United States Department of the Interior, Bureau of Land Management or by a decree of a court of law. Furthermore, that the corner points mentioned in lines 3, 4 and 5 above were, in a field survey on _____, 19____, found, recovered, restored, established or re-established as expressed below and in conformance with the rules of the Michigan State Board of Registration for Land Surveyors or, by a Decree of a Court of Law:

A. Description of original monument and accessories and/or subsequent restoration:

B. Description of corner evidence found and/or method applied in restoring or re-establishing corner:


- E-6 SET BY PROPORTIONATE MEASUREMENT, MIDPOINT ON LINE, BETWEEN SECTION CORNERS.
- E-7 FOUND 1 1/4" IRON PIPE IN PLACE AS ESTABLISHED BY M. SCHAAF IN 1940'S SURVEY.

C. Description of monument for corner and accessories established to perpetuate locating the position of the corner:

E-6	E-7
SET DNR MONUMENT	SET DNR MONUMENT
8" CEDAR N32°W 16.4' (1/4 NBT)	12" J.PINE N35°W 52.3' (S17,NBT)
7" CEDAR N21°E 10.3' (1/4 NBT)	8" ASPEN S12°W 6.6' (S20,NBT)
5" CEDAR S29°W 6.6' (1/4 NBT)	

SIGNED BY *Kenneth J. Ostling*
 SURVEYOR'S MICHIGAN REGISTRATION NO. 10068

DATE *3-18-87*

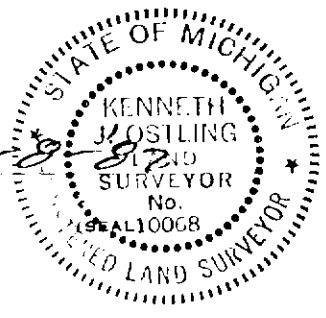

FOR STATE AND UNITED STATES AGENCIES:

SIGNED BY _____ DATE _____
CHIEF OF SURVEY PARTY

APPROVED AND SIGNED BY _____ DATE _____
MICHIGAN REGISTERED LAND SURVEYOR

SURVEYOR'S MICHIGAN REGISTRATION NO. _____ CRAWFORD COUNTY

MAY PLACE SKETCH ON BACK OR ATTACHED SHEET