

SURVEY & REMONUMENTATION

APR 27 1995

COMMISSION

CRAWFORD COUNTY
PEER GROUP APPROVAL
Date Dec 22, 1994

LIBER 3 PAGE 202

Marvin E. Myers
Marvin E. Myers, P.S.

CRAWFORD COUNTY REMONUMENTATION
LAND CORNER RECORDATION CERTIFICATE
Filing Requirement of Act 74, Mich. P.A. 1970

ALSO ACT 345, PA 1990

For corners in

CRAWFORD (County)	Located In:	Corner Code #
1. Public Land Survey	T <u>28N</u> R <u>2W</u>	<u>M-12</u>
	T _____ R _____	_____
	T _____ R _____	_____
	T _____ R _____	_____
2. Property Controlling in Section	S _____ T _____ R _____	_____
	S _____ T _____ R _____	_____
3. Miscellaneous Property in Sec.	S _____ T _____ R _____	_____
	S _____ T _____ R _____	_____

STATE OF MICHIGAN
CRAWFORD COUNTY
RECORDED

10 FEB 95 8:41 A.M.

ELIZABETH H. WIELAND
REGISTER OF DEEDS

Register of Deeds Stamp & File Number

4. Lot No. _____, Recorded Plat _____
5. Private Claims _____

	A	B	C	D	E	F	G	H	I	J	K	L	M
2	6	5	4	3	2								
3													
4	7	8	9	10	11	12							
5													
6	18	17	16	15	14	13							
7													
8	19	20	21	22	23	24							
9													
10	30	29	28	27	26	25							
11													
12	31	32	33	34	35	36							
13													

I, Wayne E. Boss, in a field survey on December 8, 19 94, do hereby certify that under requirements of P.A. 74, Michigan P.A. of 1970, the corner points mentioned in lines 1 and 2 above were in conformance with regulations and rules therefore as required in the current manual of survey instructions of the United States Department of the Interior, Bureau of Land Management or by a decree of a Court of Law and/or that the corner points mentioned in lines 3, 4 and 5 above were in conformance with the rules of the Michigan Board of Land Surveyors or by a Decree of a Court of Law; established, re-established, monumented, re-monumented, recovered, found as expressed below:

NOTE: Not more than 4 corners, all in the same town and range, may be recorded on this certificate.

A. Description of original monument and accessories and/or subsequent restoration:

- | | |
|-----------------------------|--------------------|
| G.L.O. James Mullet 1839 | 1/2" Bar & Cap Set |
| Set quarter Section Post | by Fred King 1991. |
| 1. y Pine 20" S22°W, 9 lks. | L. 331, pg. 107. |
| 2. y Pine 6" N62°W, 15 lks. | No cor. record Fd. |

B. Description of corner evidence found and/or method applied in restoring or reestablishing corner:

1/2" Bar & Cap set by Fred King in 1991 by single proportionate measure between M-11 and M-13.

- G.L.O. Mullet dist. to M-13 2640 Meas. 2637.94' (King).
G.L.O. Mullet dist. to M-11 2640 Meas. 2637.94' (King).


C. Description of monument for corner and accessories established to perpetuate locating the position of the corner:

- M-12 Crawford Co. Mon. set at exact location of 1/2" Bar.
1. Set Blz. & Spk. 6" Oak N22°E, 19.24'.
2. Set Blz. & Spk. 6" Oak N50°E, 21.44'.
3. Set Blz. & Spk. 6" Oak N85°E, 25.23'.
4. Set Blz. & Spk. 6" Oak S02°W, 18.55'.

And is accepted as a careful and faithful reestablishment of the position of the original corner.

Signed by Wayne E. Boss
Surveyor's Michigan License No. 20703

Date January 23, 1995

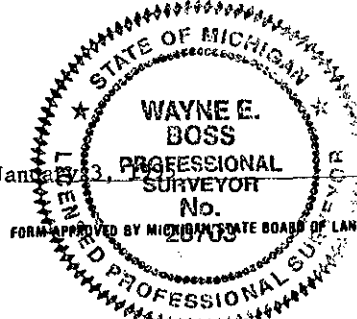

FORM APPROVED BY MICHIGAN BOARD OF LAND SURVEYORS, JAN. 26, 1971
REVISED MAY 14, 1975
REVISED JAN., 1983