

Crawford Co

LAND CORNER RECORDATION CERTIFICATE

FILING REQUIREMENT OF ACT 74, MICH. P.A.1970

FOR CORNERS OF--:	LOCATED IN--:	CORNER CODE NUMBER
1. PUBLIC LAND SURVEY.....	T. 28 N. R. 2 W.	D-13;E-13;F-13;G-13
2. PROPERTY CONTROLLING IN SECTION.....	T. N. S. R. E. W.	
3. MISCELLANEOUS PROPERTY IN SECTION.....	T. N. S. R. E. W.	
4. LOT NO....., RECORDED PLAT.....		
5. PRIVATE CLAIMS.....		

REGISTER OF DEEDS STAMP AND FILING NUMBER

I, Kenneth J. Ostling, do hereby certify that under requirements of P.A. 74, Michigan P.A. of 1970, the corner points mentioned in lines 1 and 2 above were, in a field survey on May 9, 1979, established, re-established, monumented, re-monumented, recovered or restored as expressed below and in conformance with regulations and rules therefore as required in the current manual of survey instructions of the United States Department of the Interior, Bureau of Land Management or by a decree of a court of law. Furthermore, that the corner points mentioned in lines 3, 4 and 5 above were, in a field survey on _____, 19____, found, recovered, restored, established or re-established as expressed below and in conformance with the rules of the Michigan State Board of Registration for Land Surveyors or, by a Decree of a Court of law:

~~A. Description of original monument and accessories and for subsequent restoration:~~

C. (continued)

	G-13
	Set DNR Monument & Cedar Post
	10" Maple N20°W 60.63
	5" Oak N68°E 18.49

B. Description of corner evidence found and/or method applied in restoring or re-establishing corner:

- D-13 Found 1½" pipe as established in previous survey by Marcus Schaaf. Falls on west side of N-S road.
- E-13 Found 1½" pipe as established in 1935 survey by Schaaf, in which the entire township line was restored.
- F-13 Found 1½" pipe as previously established in 1935 Schaaf survey. Previously set by proportionate measurement.
- G-13 Found 1½" pipe as restored in 1935 survey by Schaaf, during a resurvey of this township line.

C. Description of monument for corner and accessories established to perpetuate locating the position of the corner:

D-13			E-13			F-13		
Set DNR Monument & Cedar Post			Set DNR Monument & Cedar Post			DNR Monument & Cedar Post		
7" J. Pine	N64°W	24.44	9" Oak	N58°E	13.16	4" R. Pine	S01°E	66.65
10" J. Pine	N60°E	7.41	5" J. Pine	N37°W	20.52	5" J. Pine	N85°E	25.43


SIGNED BY Kenneth J. Ostling DATE _____

SURVEYOR'S MICHIGAN REGISTRATION NO. 10068

FOR STATE AND UNITED STATES AGENCIES.

SIGNED BY _____ DATE _____
CHIEF OF SURVEY PARTY

APPROVED AND SIGNED BY _____ DATE _____
MICHIGAN REGISTERED LAND SURVEYOR

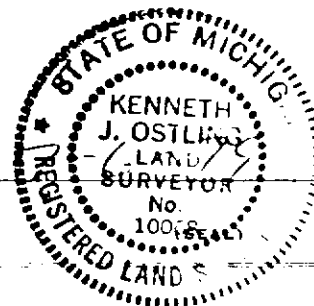

SURVEYOR'S MICHIGAN REGISTRATION NO. _____ CRAWFORD COUNTY