

LAND CORNER RECORDATION CERTIFICATE

FILING REQUIREMENT OF ACT 74, MICH. P.A.1970

FOR CORNERS OF--:	LOCATED IN--:	CORNER CODE NUMBER
1. PUBLIC LAND SURVEY	T. 28 N. R. 2 W.	F-9
2. PROPERTY CONTROLLING IN SECTION 28	T. 28 N. R. 2 W.	15; 16
3. MISCELLANEOUS PROPERTY IN SECTION 28	T. 28 N. R. 2 W.	F-11/16
4. LOT NO. _____, RECORDED PLAT _____		
5. PRIVATE CLAIMS _____		

REGISTER OF DEEDS STAMP AND FILING NUMBER

I, Kenneth J. Ostling, do hereby certify that under requirements of P.A. 74, Michigan P.A. of 1970, the corner points mentioned in lines 1 and 2 above were, in a field survey on November 6, 1978, established, re-established, monumented, re-monumented, recovered or restored as expressed below and in conformance with regulations and rules therefore as required in the current manual of survey instructions of the United States Department of the Interior, Bureau of Land Management or by a decree of a court of law. Furthermore, that the corner points mentioned in lines 3, 4 and 5 above were, in a field survey on November 6, 1978, found, recovered, restored, established or re-established as expressed below and in conformance with the rules of the Michigan State Board of Registration for Land Surveyors or, by a Decree of a Court of law:

A. - Description of original monument and accessories and/or subsequent restoration:

C. (continued)

F-11/16
 Set 5/8" Rod w/RLS Cap & cedar post
 2" W. Pine S02°E 5.26
 2" R. Pine S58°E 11.30


B. Description of corner evidence found and/or method applied in restoring or re-establishing corner:

- F-9 Found 1/2" iron bar in north ditch as established in previous survey by Ostling Surveys, Inc. Corner was established to reflect deflection at 1/4 corner called for in U.S. notes.
- 15 Set corner by standard survey procedure for the subdivision of sections.
- 16 Set corner by standard survey procedure for the subdivision of sections.
- F-11/16 Set M.C. on S line on E side KP Lake. Unable to identify U.S. evidence or previous corner.

C. Description of monument for corner and accessories established to perpetuate locating the position of the corner:

F-9	15	16
Fd. 1/2" bar; set DNR mon. & cedar post	Set 5/8" rod w/RLS Cap & cedar post	Set 5/8" Rod w/RLS Cap & ced. post
10" B. Oak N09°W 36.04	10" W. Oak S14°W 12.78	3" Twin Maple N60°E 1.93
10" B. Oak N56°E 44.12	4" W. Oak S85°E 27.62	4" R. Oak N53°W 7.60
	E-W Trail Rd. North 23'	

SIGNED BY Kenneth J. Ostling DATE 12-5-78
 SURVEYOR'S MICHIGAN REGISTRATION NO. 10068

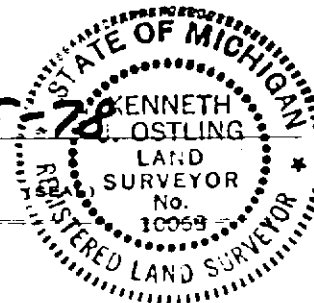

FOR STATE AND UNITED STATES AGENCIES:

SIGNED BY _____ DATE _____
CHIEF OF SURVEY PARTY
 APPROVED AND SIGNED BY _____ DATE _____
MICHIGAN REGISTERED LAND SURVEYOR (SEAL)

SURVEYOR'S MICHIGAN REGISTRATION NO. _____ CRAWFORD COUNTY