

# LAND CORNER RECORDATION CERTIFICATE

Filing Requirement of Act 74, Mich. PA 1970

For Corners In: Crawford (County)	Located In	Corner Code #
1. Public Land Survey	T 28N R 3W	I-7
2. Property Controlling in Section	S T R	
3. Miscellaneous Property in Section	S T R	

Register of Deeds Stamp & File Number

4. Lot No: \_\_\_\_\_ Recorded Plat: \_\_\_\_\_

5. Private Claims: \_\_\_\_\_

I, Carl T. Kiiskila, in a field survey on November 23, 2008 do hereby state that under requirements of PA 74, Michigan PA of 1970, the corner points mentioned in lines 1 and 2 above were in conformance with regulations and rules therefore as required in the current manual of survey instructions of the United States Department of the Interior, Bureau of Land Management or by a decree of a Court of Law and/or that the corner points mentioned in lines 3, 4 and 5 above were in conformance with the rules of the Michigan Board of Land Surveyors or by a Decree of a Court of Law, established, re-established, monumented, recovered, found as expressed below:

**NOTE: Not more than 2 corners, all in the same town and range, may be recorded on this certificate.**

	A	B	C	D	E	F	G	H	I	J	K	L	M
1													
2	6	5	4	3	2	1							
3													
4	7	8	9	10	11	12							
5													
6	18	17	16	15	14	13							
7													
8	19	20	21	22	23	24							
9													
10	30	29	28	27	26	25							
11													
12	31	32	33	34	35	36							
13													

A. Description of original monument and accessories and/or subsequent restoration:

I-7 **1856** – GLO – Walter Warner – Reestablished old Corner of sections 14,15,22 & 23.  
 Maple 14 N75°30'E 35 links  
 Sugar 12 S75°30'W 33 links  
**1969** – Survey Map – Norman F. Parker -P.S.#16939  
 - Placed 3/4"x30" Iron Bar.  
 P.K nail in fence cor. N10°W 42.25'  
 P.K. nail in 8" N. Pine N10°W 72.25'  
 P.K. nail in 6" N. Pine S75°W 97.75'


**1995** – Certificate of Survey - Unrecorded – Robert F. Mitchell P.S.#28417 – Fnd. 2" Pipe.  
**1995** – L.C.R.C – L.3, pg.223 – Robert F. Mitchell P.S. #28417 – Found 2" pipe w/spike inside. Accepted 2" pipe as a perpetuation of the original corner.  
 Set spike N. sd 10" R. Pine S77°W 67.40'  
 Set spike W. sd P.P. N46°W 46.50'  
 Set spike N. sd 10" P.P. N50°E 45.30'  
 Set spike SW. sd 16" R. Pine N33°W 81.90'

B. Description of corner evidence found and/or method applies in restoring or re-establishing corner:

I-7 Section corner common to secs. 14,15,22 & 23, T28N,R3W.  
 Pulled witnesses per L.C.R.C., L.3, pg.223, could not find any evidence of 2" pipe. Reset corner from witnesses per L.C.R.C., L.3, pg.223. Accepted reset position as the best available evidence of the position of the original corner.

C. Description of monument for corner and accessories established to perpetuate locating the position of the corner:

I-7 Section corner common to secs. 14,15,22 & 23, T28N,R3W.  
 Set stamped 4" dia. Alum. Standard DNR monument on 1"x36" galvanized pipe.  
 Wit:N56°E 46.47' to fd. nail on S side P.Pole  
 N56°E 45.27' to fd. nail on SE side P.Pole  
 N29°W 81.87' to fd. nail on N side 18" R.Pine  
 S85°W 67.34' to fd. nail on N side 12" R.Pine  
 S02°W 146.12' to set P.K.&T on W side P.Pole

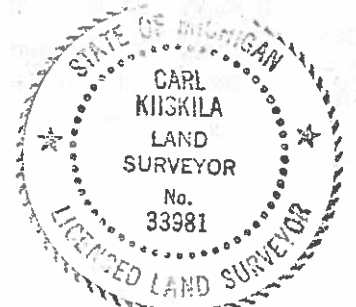

Signed by: Carl T. Kiiskila  
 Surveyor's Michigan License No.: 33981

Date: 1-6-10