

MAR 29 2000

SECTION

LAND CORNER RECORDATION CERTIFICATE

Filing Requirement of Act 74, Mich. P.A. 1970

For corners in CRAWFORD (County)

Located In:

Corner Code #

- 1. Public Land Survey T 28N R 3W J - 11
2. Property Controlling in Section S T R
3. Miscellaneous Property in Sec. S T R

STATE OF MICHIGAN CRAWFORD COUNTY RECORDED

28 DEC 99 3:03 P.M.

SANDRA MOORE REGISTER OF DEEDS

Register of Deeds Stamp & File Number

- 4. Lot No. , Recorded Plat
5. Private Claims

LIBER 4 PAGE 77

I, Marvin E. Myers, in a field survey on April 9, 1999, do hereby certify that under requirements of P.A. 74, Michigan P.A. of 1970, the corner points mentioned in lines 1 and 2 above were in conformance with regulations and rules therefore as required in the current manual of survey instructions of the United States Department of the Interior, Bureau of Land Management or by a decree of a Court of Law and/or that the corner points mentioned in lines 3, 4 and 5 above were in conformance with the rules of the Michigan Board of Land Surveyors or by a Decree of a Court of Law; established, re-established, monumented, re-monumented, recovered, found as expressed below:

Grid table with columns A-L and rows 2-13. Contains numbers 1-36 in a grid pattern.

NOTE: Not more than 4 corners, all in the same town and range, may be recorded on this certificate.

A. Description of original monument and accessories and/or subsequent restoration:

James H. Mullet, D.S. Norman F. Parker R.L.S. #16939
G.L.O. 1839 Unrecorded survey of Section 26
Mon.-Post Mon: 1" Pipe in road
Wit: 14" Beech N04°W 22 links Wit: none provided
4" Beech S41°E 19 links

B. Description of corner evidence found and/or method applied in restoring or reestablishing corner:

Found 1" pipe of record in the centerline of County Road 612 East and West 46' South of a red topped D.N.R. marker post. Accepted pipe the best available evidence of the position of the original corner. Replaced 1" pipe with Standard Crawford County Monument.

CRAWFORD COUNTY PEER GROUP APPROVAL


DATE Sept 10, 1999

Signature of Marvin E. Myers

Marvin E. Myers, P.S. County Surveyor

C. Description of monument for corner and accessories established to perpetuate locating the position of the corner:

Mon: Standard Crawford County Corner
Wit: Set spike in 8" Maple S26°E 94.63'
Set spike in utility pole S13°E 60.13'
Set spike in 8" quad Maple N21°W 69.46'
Set spike in 12" White Pine N20°E 50.18'
Set Carsonite Post North 46.3'

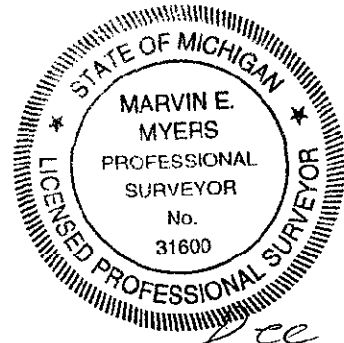

Signed by Marvin E. Myers

Date Dec 9, 1999

Surveyor's Michigan License No. 31600