

MAR 22 1999

LIBER 3 PAGE 345

SECTION

LAND CORNER RECORDATION CERTIFICATE
Filing Requirement of Act 74, Mich. P.A. 1970

For corners in

Crawford
(County)

Located In:

Corner Code #

- | | | |
|------------------------------------|----------------|--------|
| 1. Public Land Survey | T28N R4W | D-13 ✓ |
| | T27N R4W | D-1 |
| | T___ R___ | _____ |
| | T___ R___ | _____ |
| 2. Property Controlling in Section | S___ T___ R___ | _____ |
| | S___ T___ R___ | _____ |
| 3. Miscellaneous Property in Sec. | S___ T___ R___ | _____ |
| | S___ T___ R___ | _____ |

STATE OF MICHIGAN
CRAWFORD COUNTY
RECORDED

31 DEC 98 9:38 A.M.

SANDRA MOORE
REGISTER OF DEEDS

Register of Deeds Stamp & File Number

4. Lot No. _____, Recorded Plat _____
5. Private Claims _____

I, James L. Schwandt, in a field survey on 10/15, 1998 hereby certify that under requirements of P.A. 74, Michigan P.A. of 1970, the corner points mentioned in lines 1 and 2 above were in conformance with regulations and rules therefore as required in the current manual of survey instructions of the United States Department of the Interior, Bureau of Land Management or by a decree of a Court of Law and for that the corner points mentioned in lines 3, 4 and 5 above were in conformance with the rules of the Michigan Board of Land Surveyors or by a Decree of a Court of Law; established, re-established, monumented, re-monumented, recovered, found as expressed below:

	A	B	C	D	E	F	G	H	I	J	K	L
1												
2	6		5		4		3		2		1	
3												
4	7		8		9		10		11		12	
5												
6	18		17		16		15		14		13	
7												
8	19		20		21		22		23		24	
9												
10	30		29		28		27		26		25	
11												
12	31		32		33		34		35		36	
13												

A. Description of original monument and accessories and/or subsequent restoration:

- 1.) D-13, T28N-R4W; G.L.O., James Mullett, 1839; Set Post; W. Oak 10.0", N38°E, 35 links; W. Oak 8.0", N63°W 27 links; M.O.L.
- 2.) M. Schaff; Set Post, 1939; No wits.


B. Description of corner evidence found and/or method applied in restoring or reestablishing corner:

Found concrete monument
Found spike in 8.0" White Oak, N65°E, 22.44'
Found spike in 8.0" Red Oak, N03°E, 18.44'

C. Description of monument for corner and accessories established to perpetuate locating the position of the corner:

Monument: Concrete monument left in place, accepted position as a careful and faithful establishment of the position of the corner.

- Wit: Spike 8.0", White Oak, N65°E, 22.44'
Spike 8.0", Red Oak, N03°E, 18.44'
Set spike, 5.0" White Oak, S11°W, 26.17'
Set spike, 12.0" White Oak, S79°W, 25.53'

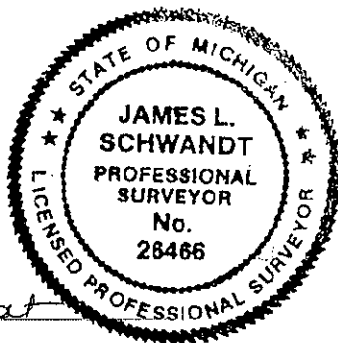

CRAWFORD COUNTY
PEER GROUP APPROVAL
DATE Aug 21, 1998

Marvin E. Myers
Marvin E. Myers, P.S.
County Surveyor

Signed by James L. Schwandt
Surveyor's Michigan License No. _____

Date 10-15-98