

MAR 2 1999

LIBER 3 PAGE 347

LAND CORNER RECORDATION CERTIFICATE
Filing Requirement of Act 74, Mich. P.A. 1970

For corners in

Crawford
(County)

Located In:

Corner Code #

1. Public Land Survey

T28N R4W

F-13

T27N R4W

E-1

T R

T R

2. Property Controlling in Section

S

T R

S

T R

3. Miscellaneous Property in Sec.

S

T R

S

T R

STATE OF MICHIGAN
CRAWFORD COUNTY
RECORDED

31 DEC 98 - 9:39 A.M.

SANDRA MOORE
REGISTER OF DEEDS

Register of Deeds Stamp & File Num

4. Lot No. _____, Recorded Plat _____
5. Private Claims _____

I, James L. Schwandt, in a field survey on 10/15, 1998 hereby certify that under requirements of P.A. 74, Michigan P.A. of 1970, the corner points mentioned in lines 1 and 2 above were in conformance with regulations and rules therefore as required in the current manual of survey instructions of the United States Department of the Interior, Bureau of Land Management or by a decree of a Court of Law and/or that the corner points mentioned in lines 3, 4 and 5 above were in conformance with the rules of the Michigan Board of Land Surveyors or by a Decree of a Court of Law; established, re-established, monumented, re-monumented, recovered, found as expressed below:

A	B	C	D	E	F	G	H	I	J	K	L
1											
2	6		5		4		3		2		
3											
4	7		8		9		10		11		1
5											
6	18		17		16		15		14		1
7											
8	19		20		21		22		23		2
9											
10	30		29		28		27		26		2
11											
12	31		32		33		34		35		3
13											

A. Description of original monument and accessories and/or subsequent restoration:


- 1.) F-13, T28N-R4W; G.L.O. James Mullett, 1839; Set Post; Maple 8", N85°W, 18 links; White Oak 8", N2 1/2°E 16 links.
- 2.) A.E. Newman, 1900; Set Post; White Pine stump 30", N89°E, 25 links; White Pine stump 22", West, 21 links.
- 3.) Kenneth J. Ostling, #10068, 1973; Set DNR monument midpoint on line between section corners as previously established by Houghton. 10" White Oak, N09°E, 19.2'; 7" Red Oak, S78°E, 5.75'.

B. Description of corner evidence found and/or method applied in restoring or reestablishing corner:

- 1.) Found 1/2" bar; Found spike and blaze, 3.0" Oak, N30°E, 10.40'; Found spike and blaze, 8.0" Oak, S75°E, 6.0' Found spike and blaze, 12.0" Oak, S5°W, 8.20'; Found spike and blaze, 10.0" Poplar, S88°W, 49.36'.

C. Description of monument for corner and accessories established to perpetuate locating the position of the corner:

- Mon: Replaced 1/2" bar with Crawford County Monument, accepted as the best available evidence of the position the original corner.
- Wit: Spike and blaze, 3.0" Oak, N30°E, 10.40'
- Spike and blaze, 8.0" Oak, S75°E, 6.0'
- Spike and blaze, 12.0" Oak, S5°W, 8.20'
- Spike and blaze, 10.0" Poplar, S88°W, 49.36'

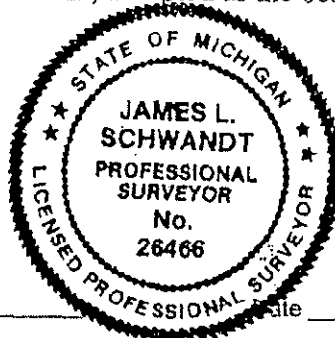

CRAWFORD COUNTY
PEER GROUP APPROVAL

DATE Aug 21, 1998

Marvin E. Myers

Marvin E. Myers, P.S.
County Surveyor

Signed by James L. Schwandt
Surveyor's Michigan License No. _____

26466

File 10-15-98