

MAR 22 1999

LIBER

3 PAGE 348

SECTION

LAND CORNER RECORDATION CERTIFICATE
Filing Requirement of Act 74, Mich. P.A. 1970

For corners in

Crawford
(County)

Located In:

Corner Code #

1. Public Land Survey

T28N R4W

G-13 ✓

T27N R4W

G-1

T R

T R

2. Property Controlling
in Section

S

T R

3. Miscellaneous
Property in Sec.

S

T R

S

T R

S

T R

STATE OF MICHIGAN
CRAWFORD COUNTY
RECORDED

31 DEC 98 9:39 A.M.

SANDRA MOORE
REGISTER OF DEEDS

Register of Deeds Stamp & File Number

4. Lot No. _____, Recorded Plat _____

5. Private Claims _____

I, James L. Schwandt, in a field survey on 10/15, 1998 to hereby certify that under requirements of P.A. 74, Michigan P.A. of 1970, the corner points mentioned in lines 1 and 2 above were in conformance with regulations and rules therefore as required in the current manual of survey instructions of the United States Department of the Interior, Bureau of Land Management or by a decree of a Court of Law and for that the corner points mentioned in lines 3, 4 and 5 above were in conformance with the rules of the Michigan Board of Land Surveyors or by a Decree of a Court of Law; established, re-established, monumented, re-monumented, recovered, found as expressed below:

	A	B	C	D	E	F	G	H	I	J	K	L
1												
2		6		5		4		3		2		1
3												
4		7		8		9		10		11		12
5												
6		18		17		16		15		14		13
7												
8		19		20		21		22		23		24
9												
10		30		29		28		27		26		25
11												
12		31		32		33		34		35		36
13												

A. Description of original monument and accessories and/or subsequent restoration:

- 1.) G-13, T28N-R4W; G.L.O. James H. Mullett, 1839; Set Post; Beech 10", N24°W, 29 links; Beech 10", N39°E, 32 links.
- 2.) A.E. Newman, 1900; Sunk piece railroad iron 2' long for corner.
- 3.) E. Houghton, 1923; Set Concrete filled tile; USGS Monument, N16°30'E, 26.60'.
- 4.) Kenneth J. Ostling, #10068, 1973; Boat spike over another iron; Previously witnessed by Houghton; 23" Maple, N55°E, 57.2'; USGS Mon. N18°E, 26.45'; 13" Beech, S28°E, 73.9'.
- 5.) Norman F. Parker, #16939, 1975; Iron in black top; 26" Maple, N54°E, 57.25'; 20" Maple, S42°E, 73.40'.
- 6.) James L. Schwandt, #26466, 1993; Found 3/4" Bar (XX is 10' West); 28" Maple, N54°E, 58.13'; 24" Maple, S42°E, 73.81'; 22" Beech, S30°E, 74.43'; Power pole, S45°W, 56.79'.

B. Description of corner evidence found and/or method applied in restoring or reestablishing corner:

- 1.) Found 3/4" bar (XX is 10.0' West); Found James L. Schwandt Tag #26466 in 28.0" Maple, N54°E, 58.10'; Found James L. Schwandt Tag #26466 in power pole, S45°W, 56.78'; Found 24.0" Maple, S42°E, 73.60'; Found 22.0" Beech, S30°E, 74.32'.

C. Description of monument for corner and accessories established to perpetuate locating the position of the corner:


Mon: Replaced 3/4" bar with Crawford County Monument, accessories the best available evidence of the position of the origin corner.

Wit: Nail and Tag, 28.0" Maple, N54°E, 58.10'

Nail and Tag, power pole, S45°W, 56.78'

Set spike in 24.0" Maple, S42°E, 73.60'

Set spike in 22.0" Beech, S30°E, 74.32'

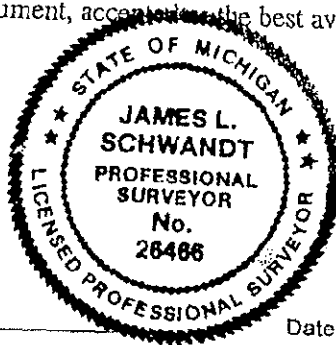

CRAWFORD COUNTY

PEER GROUP APPROVAL

DATE Dec 21, 1998

Marvin E. Myers

Marvin E. Myers, P.S.
County Surveyor

Date 10-15-98

Signed by James L. Schwandt

Surveyor's Michigan License No. _____

26466