

MAR 22 1999

LIBER 3 PAGE 349

SECTION

LAND CORNER RECORDATION CERTIFICATE
Filing Requirement of Act 74, Mich. P.A. 1970

For corners in

Crawford (County)	Located In:	Corner Code #
1. Public Land Survey	T28N R4W	H-13 ✓
	T27N R4W	H-1
	T___ R___	_____
	T___ R___	_____
2. Property Controlling in Section	S___ T___ R___	_____
	S___ T___ R___	_____
3. Miscellaneous Property in Sec.	S___ T___ R___	_____
	S___ T___ R___	_____

STATE OF MICHIGAN
CRAWFORD COUNTY
RECORDED

31 DEC 98 9:39 A.M.

SANDRA MOORE
REGISTER OF DEEDS

Register of Deeds Stamp & File Num

4. Lot No. _____, Recorded Plat _____
5. Private Claims _____

I, James L. Schwandt, in a field survey on 10/15, 1998 hereby certify that under requirements of P.A. 74, Michigan P.A. of 1970, the corner points mentioned in lines 1 and 2 above were in conformance with regulations and rules therefore as required in the current manual of survey instructions of the United States Department of the Interior, Bureau of Land Management or by a decree of a Court of Law and for that the corner points mentioned in lines 3, 4 and 5 above were in conformance with the rules of the Michigan Board of Land Surveyors or by a Decree of a Court of Law; established, re-established, monumented, re-monumented, recovered, found as expressed below:

	A	B	C	D	E	F	G	H	I	J	K	L
1												
2	6		5		4		3		2			1
3												
4	7		8		9		10		11			1
5												
6	18		17		16		15		14			1
7												
8	19		20		21		22		23			2
9												
10	30		29		28		27		26			2
11												
12	31		32		33		34		35			3
13												

A. Description of original monument and accessories and/or subsequent restoration:

- 1.) H-13, T28N-R4W; G.L.O. James H. Mullett, 1839; Set Post; Beech 8", N10°W, 14 links; Hemlock 8", N29°E, 6 links.
- 2.) Kenneth J. Ostling, #10068, 1972-1974; Corner used in boundary retracement survey; No description of corner survey.
- 3.) Norman F. Parker, #16939, 1984; Found 1/2" bar at fence corner; 8" Maple, N33°W, 20.8'; 10" Maple, S5°E, 21.5'; 12" Maple, N85°E, 23.2'.

B. Description of corner evidence found and/or method applied in restoring or reestablishing corner:

- 1.) Found 1/2" bar, fence corner is laying on the ground; Found P.K. nail and blaze, 8.0" Maple, N20°W, 21.20'; Found P.K. nail and blaze, 10.0" Maple, S5°E, 22.05'; Found P.K. nail and blaze, 12.0" Maple, N85°E, 23.0'; Found spike and blaze, 7.0" Maple, N55°W, 8.75'.


C. Description of monument for corner and accessories established to perpetuate locating the position of the corner:

Mon: Replaced 1/2" bar with Crawford County Monument, accepted as the best available evidence of the position of the original corner.
Wit: P.K. nail and blaze, 8.0" Maple, N20°W, 21.20'
P.K. nail and blaze, 10.0" Maple, S5°E, 22.05'
P.K. nail and blaze, 12.0" Maple, N85°E, 23.00'
Spike and blaze, 7.0" Maple, N55°W, 8.75'

CRAWFORD COUNTY
PEER GROUP APPROVAL
DATE Dec 21, 1998

Marvin E. Myers
Marvin E. Myers, P.S.
County Surveyor

10-15-98

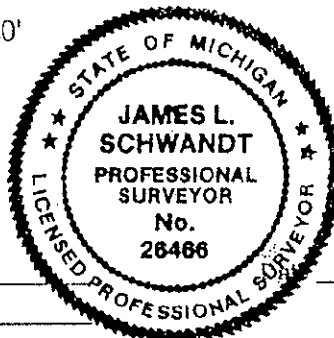

Signed by James L. Schwandt
Surveyor's Michigan License No. _____

26466