

STATE OF MICHIGAN
DEPARTMENT
OF
NATURAL RESOURCES

LAND CORNER RECORD

CRAWFORD COUNTY


T 28 N R 4 W

DESCRIPTION OF CORNER West 1/4 corner

CORNER MONUMENT Set Dept. Monument

DATE MONUMENT PLACED AND WITNESSED 5-24-72

WITNESSES TO CORNER..... 6" Bl. Cherry North 18.8'

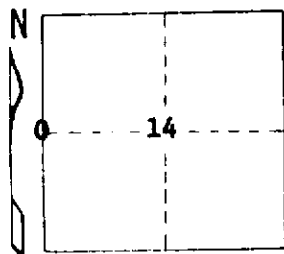

7" Bl. Cherry N 75 W 21.15'


W edge Tag Alders West 10'

AND
Top of Ridge West 80'

CIRCLE CORNER REGISTERED

DESCRIPTION IN DETAIL AS TO HOW CORNER WAS LOCATED AND IDENTIFIED OR RESTORED.

This corner set by proportionate measurement between section corners. No sign of a previous corner.

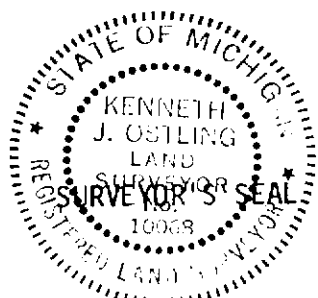

DISTRIBUTION:

SIGNED Kenneth J. Ostling DATE 5-25-72
REGISTERED LAND SURVEYOR 10068

County Courthouse
Area Forester (Regions I & II)
District or Region Surveyor
Forestry Div., Lansing

R 4047
Rev. 10/68