


STATE OF MICHIGAN  
DEPARTMENT  
OF  
NATURAL RESOURCES

LAND CORNER RECORD

CRAWFORD COUNTY  
T 28 N R 4 W

DESCRIPTION OF CORNER NE Section Corner  
CORNER MONUMENT Set Dept. Monument  
DATE MONUMENT PLACED AND WITNESSED 5-24-72  
WITNESSES TO CORNER..... 6" Maple, clump N 85 E 22.7'

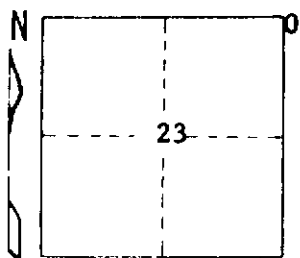


6" Maple, clump S 30 W 4.8'  
3" W. Pine S 85 W 31.1'  
AND

CIRCLE CORNER REGISTERED

DESCRIPTION IN DETAIL AS TO HOW CORNER WAS LOCATED AND IDENTIFIED OR RESTORED.

Replaced 1/2" iron bar as established by G.F. DeLaMater in 1948 survey. Corner used in all surrounding surveys.

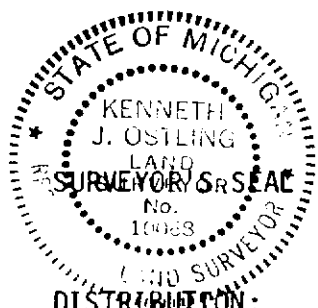

DISTRIBUTION:

SIGNED

*Kenneth J. Ostling*  
REGISTERED LAND SURVEYOR

DATE

5-25-72

10068

County Courthouse  
Area Forester (Regions I & II)  
District or Region Surveyor  
Forestry Div., Lansing

R 4047  
Rev. 10/68