


STATE OF MICHIGAN
DEPARTMENT
OF
NATURAL RESOURCES
LAND CORNER RECORD

CRAWFORD COUNTY
T 28 N R 4 W

DESCRIPTION OF CORNER SW corner Section 22
CORNER MONUMENT Left Concrete tile monument in place
DATE MONUMENT PLACED AND WITNESSED 5-5-72
WITNESSES TO CORNER.....

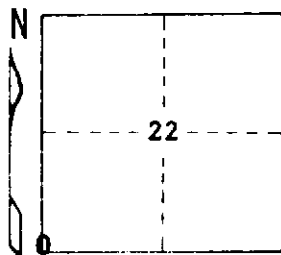

10" Elm N 51 E 37.25'


10" H. Maple N 78 W 70.00'

AND

CIRCLE CORNER REGISTERED

DESCRIPTION IN DETAIL AS TO HOW CORNER WAS LOCATED AND IDENTIFIED OR RESTORED.

Found concrete filled tile in center of N-S County road. Previously established by County Surveyor Houghton. Used in more recent surveys in this vicinity.

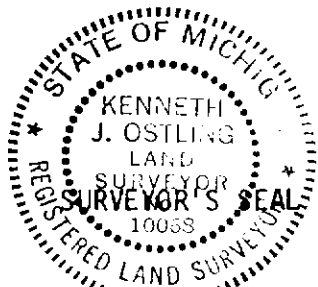

SIGNED

Kenneth J. Ostling
REGISTERED LAND SURVEYOR 10068

DATE

5-24-72

DISTRIBUTION:

County Courthouse
Area Forester (Regions I & II)
District or Region Surveyor
Forestry Div., Lansing

R 4047
Rev. 10/68