


STATE OF MICHIGAN  
DEPARTMENT  
OF  
NATURAL RESOURCES

LAND CORNER RECORD

CRAWFORD COUNTY  
T 28 N R 4 W

DESCRIPTION OF CORNER SE corner Section 26  
CORNER MONUMENT Set DNR Monument  
DATE MONUMENT PLACED AND WITNESSED 5-23-72  
WITNESSES TO CORNER.....

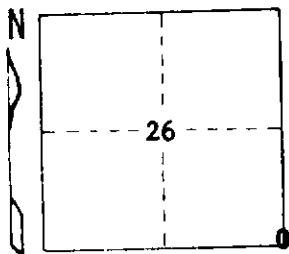


20" W. Pine N 32 W 46.6'  
16" W. Pine N 62 E 41.8'  
AND

CIRCLE CORNER REGISTERED

DESCRIPTION IN DETAIL AS TO HOW CORNER WAS LOCATED AND IDENTIFIED OR RESTORED.

Found 5/8" re-rod in corner as established in 1948 G. F. DeLaMater Survey. Used in subsequent surveys in this area.

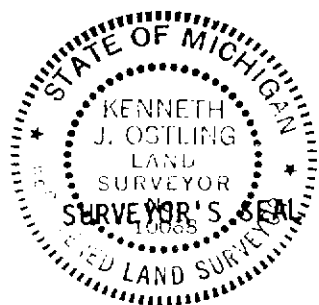

DISTRIBUTION:

SIGNED Kenneth J. Ostling DATE 5-24-72  
REGISTERED LAND SURVEYOR 10068

County Courthouse  
Area Forester (Regions I & II)  
District or Region Surveyor  
Forestry Div., Lansing

R 4047  
Rev. 10/68