


STATE OF MICHIGAN
DEPARTMENT
OF
NATURAL RESOURCES

LAND CORNER RECORD

CRAWFORD COUNTY
T 28 N R 4 W

DESCRIPTION OF CORNER NE corner Section 26
CORNER MONUMENT Set DNR Monument
DATE MONUMENT PLACED AND WITNESSED 5-23-72
WITNESSES TO CORNER.....

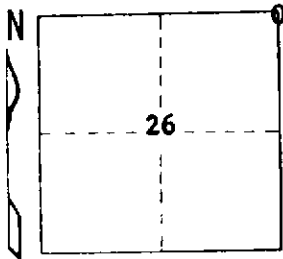


9" H. Maple S 85 E 18.6'
10" H. Maple S 15 E 33.6'
AND

CIRCLE CORNER REGISTERED

DESCRIPTION IN DETAIL AS TO HOW CORNER WAS LOCATED AND IDENTIFIED OR RESTORED.

Set this corner by proportionate measurement between corners 1 mile North, South, East and West. This appears to be very near DeLaMater's theoretical position but no previous monument could be found.

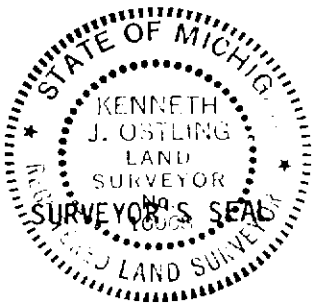

SIGNED

Kenneth J. Ostling
REGISTERED LAND SURVEYOR

DATE

5-24-72

DISTRIBUTION:

County Courthouse
Area Forester (Regions I & II)
District or Region Surveyor
Forestry Div., Lansing

10068

R 4047
Rev. 10/68