


STATE OF MICHIGAN
DEPARTMENT
OF
NATURAL RESOURCES

LAND CORNER RECORD

CRAWFORD COUNTY
T 28 N R 4 W

DESCRIPTION OF CORNER Center of Sec. 26
CORNER MONUMENT Set 1/2 x 48" Iron bar
DATE MONUMENT PLACED AND WITNESSED 6-22-72
WITNESSES TO CORNER.....

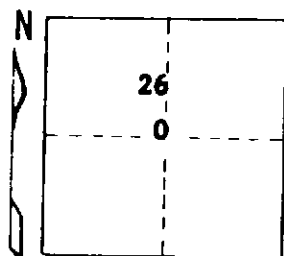


7" Cedar East 65.7'

AND

CIRCLE CORNER REGISTERED

DESCRIPTION IN DETAIL AS TO HOW CORNER WAS LOCATED AND IDENTIFIED OR RESTORED.

Set corner at the intersection of the 1/4 lines, at the latitude prescribed by G. D. Henning's 1950 survey. Corner falls 9' East of Henning's corner, which had no specific longitudinal control.

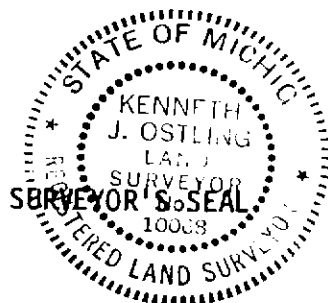

DISTRIBUTION:

Forestry Division, Lansing

SIGNED

Kenneth J. Ostling
REGISTERED LAND SURVEYOR 10068

DATE

6-29-30