

STATE OF MICHIGAN
DEPARTMENT
OF
NATURAL RESOURCES

LAND CORNER RECORD

CRAWFORD COUNTY


T 28 N R 4 W

DESCRIPTION OF CORNER South 1/16 corner on N-S 1/4 line

CORNER MONUMENT Set 2' of 1" pipe

DATE MONUMENT PLACED AND WITNESSED 6-22-72

WITNESSES TO CORNER.....

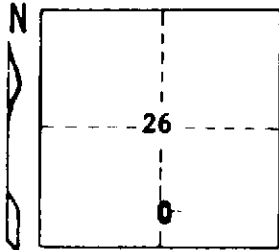

6" Maple N 40 E 1.45'


7" Maple N 82 W 20.2'

AND

CIRCLE CORNER REGISTERED

DESCRIPTION IN DETAIL AS TO HOW CORNER WAS LOCATED AND IDENTIFIED OR RESTORED.

Set by standard survey procedure to mark state land boundary.

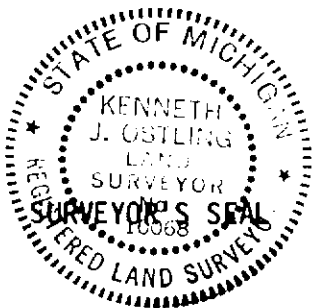

SIGNED

Kenneth J. Ostling
REGISTERED LAND SURVEYOR 10068

DATE

6-29-72

DISTRIBUTION:

Forestry Division, Lansing